

KANSAS


FORM 51 5M 6-46 PETROL

Kearny county

Section 15 Township 23 Range 35-W

Well No. #1, Campbell "B"

Company Cities Service Oil Company

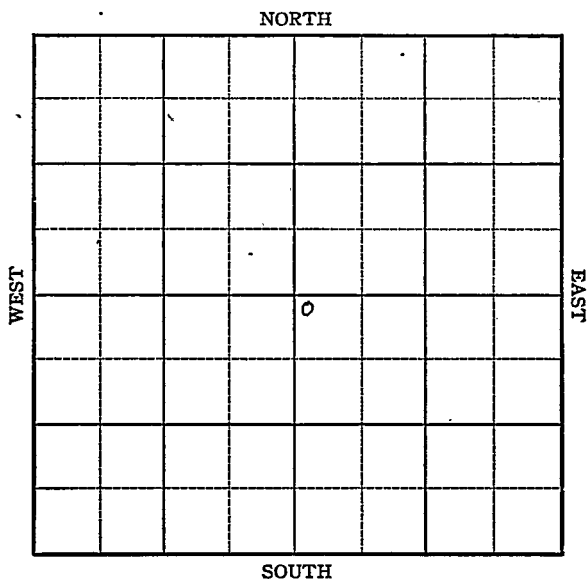

KANSAS


Kearny county ✓

Sec. 15 Twp. 23 R. 35-WWell No. #1, Campbell "B" FarmCities Service Oil Company Company

Hugoton

100' Ft. from N. Line Ft. from S. Line Ft. from E. Line100' Ft. from W. Line

NW SE

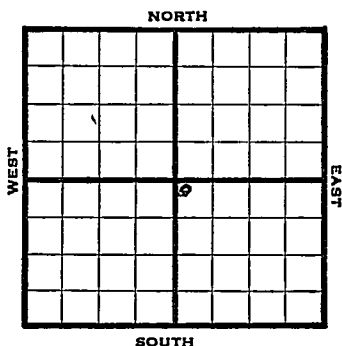

1946 Elev. 3023' REPORT

10/2	Location
10/8	"
10/15	"
10/22	"
10/29	RUR
11/6	8" @ 839'
	Drlg 1205'
11/12	TD 2710'
11/20	5" @ 2709' RUST
11/27	129 shots 2520-2590'
	4000 acid
12/3	" " "
12/10	315 shots 2115-2594'
12/17	17500 acid

1947

1/2	5" @ 2709'
	TD 2710'
	Perf
	17,500 Acid
	8,770,000 Gas
	418# RPR

COMPLETED

KANSAS Kansas Pool Name HugotonMap No. _____ Sec. 15 Twp. 23 R. 35WWell No. 1 Campbell "B"

Cities Service _____ Company

FIRST REPORT _____ Contractor

NW SE

SECTION PLAT

100 Ft. from N. Line

_____ Ft. from S. Line

_____ Ft. from E. Line

100 Ft. from W. Line

		o	

Kearny County

Location X

Rig up _____

Drilling and Remarks:

RECORD

Cased _____ in., _____ ft.

Sand _____

Gas _____

Oil _____

Total Depth _____

PRODUCTION

1st 24 hrs. Nat. _____

1st 24 hrs. after shot _____

Gas _____ Cu. Ft.

Dry Hole _____

Abandoned _____

Date

OCT 2 1946 19

S. J. LEWIS Scout

Kansas

Map No. _____ Sec. 15 Twp. 23 R. 35W

Well No. 1 Campbell "B"

Cities Service

Company

COMPLETED

Contractor

NW SE

E12023
SECTION PLAT

100 Ft. from N. Line

_____ Ft. from S. Line

_____ Ft. from E. Line

100 Ft. from W. Line

		0	

Kearny County

Location _____

Rig up _____

Drilling and Remarks:

5" @ 270°

Prof.

17500 acid

8,970,000 Gas.

418# R/B

RECORD

Cased _____ in, _____ ft.

Sand _____

Gas _____

Oil _____

Total Depth 270

PRODUCTION

1st 24 hrs. Nat. _____

1st 24 hrs. after shot _____

Gas _____ Cu. Ft.

Dry Hole _____

Abandoned _____

Date

JAN 2 1947 19

S. J. LEWIS

Scout