


Section 15 Township 23 Range 36 W

Well No. # 1 Kleeman "D"

Company Stanolind

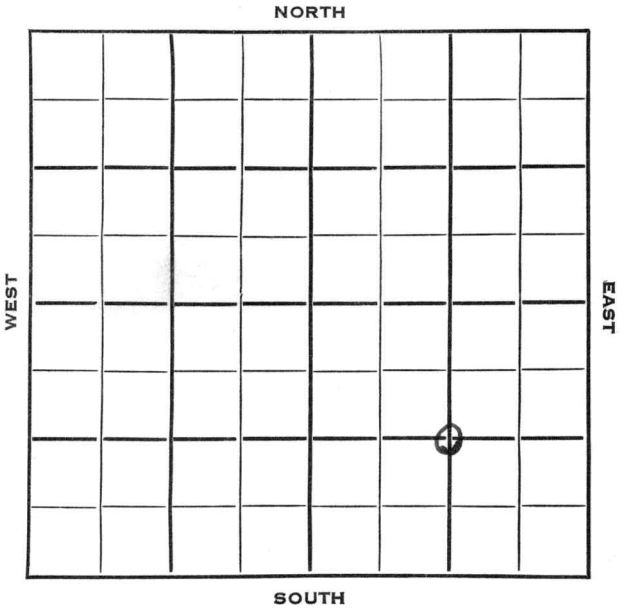

Kearny

KANSAS



Sec. 15 Twp. 23 R. 36W

Well No. #1 Kleeman "D" Farm _____

Stanolind Company _____

Hugoton Pool Contractor _____


_____ Ft. from N. Line

1320 Ft. from S. Line

1320 Ft. from E. Line

_____ Ft. from W. Line

C SE/4

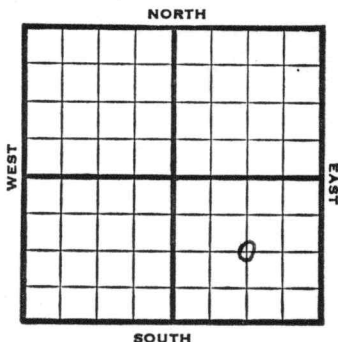

1953 Elev. 3168 GF REPORT
3174 LS

6/10 Location

6/24 8" @ 781 w/450
Her Kr 2564, Win 2625, Tow 2685, Ft. Riley 2733
RTD 2740

7/1 5" @ 2733
Testing

7/8 Spud 6-8-53 Gas well TD 2740
8" @ 781 Her.-Kri. 2564'
Win 2625 Tow. 2685 Ft. Riley 2733
TD 2740 5" @ 2733 CO to 2740
54/2569-78 24/2583-87 48/2590-98
36/2602-08 66/2625-36 48/2641-49
24/2656-60 12/2680-82 36/2686-92
30/2696-2701 18/2705-08
24/2711-15 12,250 dol-frac.
Comp. 5,207,000 gas. 400#

COMPLETED

County Kearny State Kansas

Sec. 15 (Blk. Twp.) 23 (Sur. Rge.) 36W Map No.

Operator Stanolind

Well No. 1 Farm Kleeman "D"

Elev. 3174 LS Location C SE/4
3168 GF

1320Ft. From S Line SE

1320Ft. From E Line Quarter

1st. Report

Completion JUL 8 1953

Remarks Hugoton Pool

Spudding Date 6-8-53

Drig. Data Gas well TD 2740

8" @ 781 Her-Kri. 2564 Win. 2625

Tow. 2685 Ft. Riley 2733 TD 2740

5" @ 2733 CO to 2740 54/ 2569-78

24/ 2583-87 48/ 2590-98 36/ 2602-08

66/ 2625-36 48/ 2641-49 24/ 2656-60

12/ 2680-82 36/ 2686-92 30/ 2696-2701

18/ 2705-08 24/ 2711-15 12250 dol-frac

Comp. 5,207,000 gas 400#

J. G. McGEHEE