

State **Kansas** County **Pawnee**

Company **Messman-Rinehart Oil Company** Well No. **1**

Farm **Traylor (Washdown)**


Survey **(L.J. Scharz)**

Block No. Sec. **15** Twp. **23 S** Range **16 W**

Co-Ord. Elev. **2051' K/B**

SW/4 SW/4 SE/4

M-R Rig

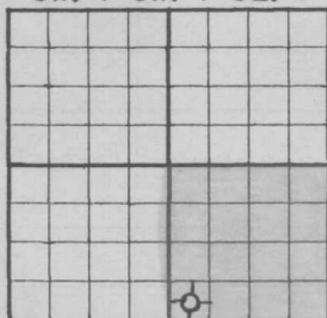

50% - Roger L. Messman
50% - C. B. Rinehart
(**\$1,000.00**)
DHM - Helmerich & Payne
Thos. Allen (**\$1,000.00**)

Washdown of Sinclair-Magnolia #1 Traylor

4250' Arbuckle test TIGHT

10-3/4" @ 962'

NOTE: Show Sketch of Lease and Well Location in Above Space

Ft. from N. Line **330** Ft. from S. Line

330 Ft. from W. Line Ft. from E. Line

Date	Depth	
12/27/62		M.I.R.T.
	(Congl.)	D.S.T. #1 - 4043-81 - Op 1 1/2 hrs., good blow throughout, Rec. 700' gas, 100' gas-cut mud, SIP 982-280#, FP 69-93#, Temp. 114°
	(Sand)	D.S.T. #2 - 4081-4119' - Op 1 hr., fair blow, died

