

KANSAS

Reno

Section 16 Township 23 Range 10-WWell No. #2 MathesCompany Derby

|  |  |  |  |  |  |  |   |
|--|--|--|--|--|--|--|---|
|  |  |  |  |  |  |  |   |
|  |  |  |  |  |  |  |   |
|  |  |  |  |  |  |  | 0 |
|  |  |  |  |  |  |  |   |

NORTH

WEST

EAST

SOUTH

KANSAS


Reno

Sec. 16 Twp. 23 R. 10-WWell No. #2 Mathes FarmDerby Company

(Peace Creek)

       Ft. from N. Line990 Ft. from S. Line330 Ft. from E. Line       Ft. from W. Line

Elev. 1779

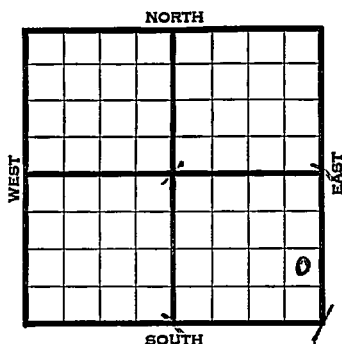

|       | REPORT                                      |
|-------|---------------------------------------------|
| 1941  |                                             |
| 11/25 | Cellar.                                     |
| 12/4  | 8" - 235' Drl g. 1890'                      |
| 12/11 | 3220                                        |
| 12/18 | Viola 3753                                  |
|       | 4" @3755 RUST                               |
| 12/24 | T.D. 3785' Swab $1\frac{1}{2}$ oil per hour |
| 12/31 | 5000' acid.                                 |
| 1942  |                                             |
| 1/8   | " "                                         |
| 1/15  | " "                                         |
| 1/22  | " "                                         |
|       |                                             |
| 1/28  | Viola 3753'                                 |
|       | 4" - 3755'                                  |
|       | T.D. 3785'                                  |
|       | 5000 acid.                                  |
|       | Potential 150 bbls., pump.                  |
|       | 42. Gravity                                 |
|       |                                             |
|       | COMPLETED                                   |
|       |                                             |
|       |                                             |


Reno

KANSAS

Map No. 47 Sec. 16 Twp. 23 R. 10WWell No. 2 MathesDerby CompanyFIRST REPORT Contractor

NE SE SE

## SECTION PLAT

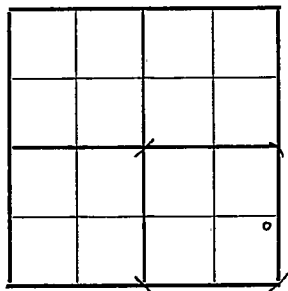       Ft. from N. Line990 Ft. from S. Line330 Ft. from E. Line       Ft. from W. Line

## PEACE CREEK POOL

Location                     Rig up                     

Drilling and Remarks:

Cellar

## RECORD

Cased            in.,            ft.Sand                     Gas                     Oil                     Total Depth                     

## PRODUCTION

1st 24 hrs. Nat.                     1st 24 hrs. after shot                     Gas                      Cu. Ft.Dry Hole                     Abandoned                     

Date

NOV 25 1941

19

S. J. LEWIS Scout

Map No. 47 Sec. 16 Twp. 23 R. 10WWell No. 2 MathesDerby

Company

COMPLETED

Contractor

NE SE SE

## SECTION PLAT

|  |  |  |  |
|--|--|--|--|
|  |  |  |  |
|  |  |  |  |
|  |  |  |  |
|  |  |  |  |

       Ft. from N. Line990 Ft. from S. Line330 Ft. from E. Line       Ft. from W. Line

PEACE CREEK POOL

Location                                 Rig up                                 

Drilling and Remarks:

*Vista 3753**4" @ 3755**5000 acid**Pump 150 P.D.**42° Gr.*

## RECORD

Cased        in.,        ft.Sand                                 Gas                                 Oil                                 Total Depth 8785

## PRODUCTION

1st 24 hrs. Nat.                                 1st 24 hrs. after shot                                 Gas                                  Cu. Ft.Dry Hole                                 Abandoned                                 

Date

JAN 28 1942 19

S. J. LEWIS

Scout