


Section 16 Township 23S Range 13W

Well No. 1 Schliz "B"

Company D. R. Lauck Oil Co.

NORTH

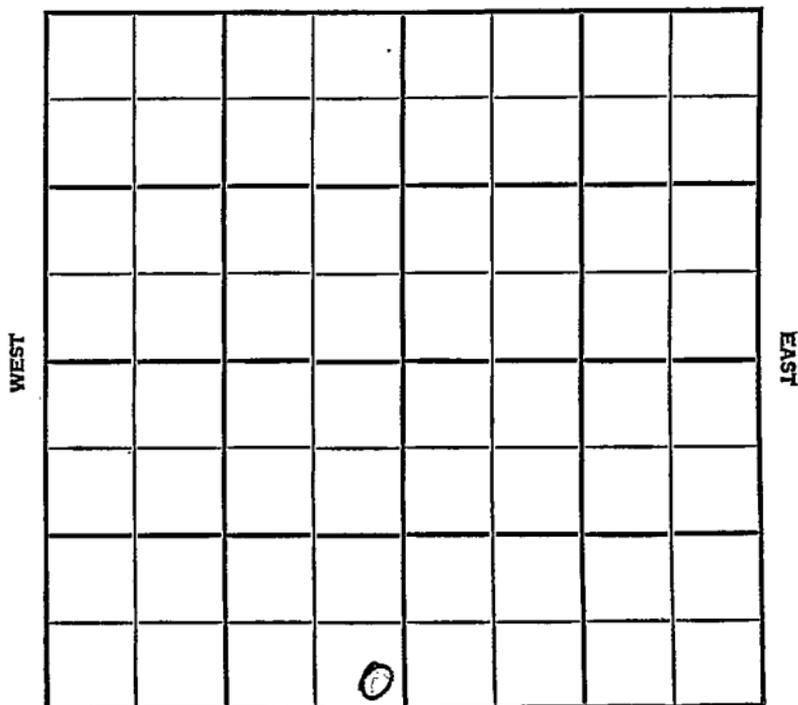

SOUTH

Stafford

KANSAS

SEC. 16	TWP. 23S	R. 13W
------------	-------------	-----------

WELL NO.

#1 Schulz "B"

FARM

COMPANY

D. R. Lauck Oil Co.

CONTRACTOR


St. John NW

_____ Ft. from N. Line

_____ Ft. from S. Line

_____ Ft. from E. Line

_____ Ft. from W. Line

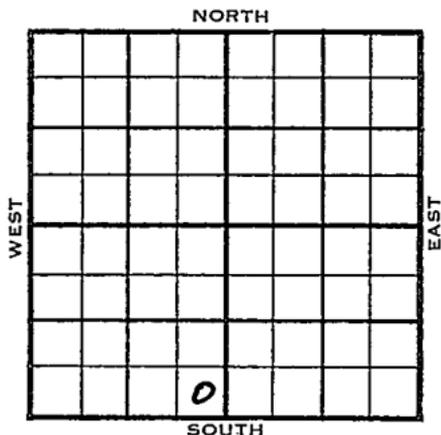

SE SE SW
DS SW/4

1955

ELEVATION

1878

REPORT

7/6

Comm 7-1-55
8" 162 w/165 sw; D 500

7/20

Comm 7-1-55

H 3314	3313
BL 3449	3448
L 3470	3470
BKC 3720	3724
Marm 3730	
V 3807	3810
S 3843	3851
A 3904	3903
TD 3945	

8" @ 162/165 DST 3493-3520 open 20 min Rec 15' mud 1145/20" DST 3652-70 open 1 hr Rec 30' mud 980/20" D & A

ABANDONED

County Stafford Elev. _____
 Sec. 16 Twp. 23S Rge. 13W
 Company D. R. Lauck Oil Co.
 Farm Name Schiz "B" No. 1

TOPS	DEPTH	LOG	DATUM	Loc. in Sec.
Anh.				SE SE SW
Tp.				DS - SW/4
H.				
Tr.				
Dg.				
Bl.				
L.				Geol. _____
K.C.				Contr. _____
B.K.C.				
Ce.				
C.				
M.				Pool _____
M.				St. John NW
K.				
Mz.				
Mo.				
V.				
S.				
S.				
A				
R.				
PE.				
G.				
T.D.				

FIRST REPORT
 JUL 6 '55
 0/

Date Comm. 7-1-55; 8" 162 w/165 sx; D 500

15

Co.
Lse.
No.
Sec.
T.
R.

County Stafford Elev. 1878

Sec. 16 Twp. 23 Rge. 13W

Company D. R. Lauck Oil Co.

FarmName Schulz "B" No. 1

TOPS	DEPTH	LOG	DATUM
Anh.			
Tp.			
H.	<u>3314</u>	<u>3313</u>	<u>1435</u>
Tr.			
Dg.			
Bl.	<u>3449</u>	<u>3448</u>	<u>1570</u>
L.	<u>3476</u>	<u>3470</u>	<u>1592</u>
K.C.			
B.K.C.	<u>3720</u>	<u>3724</u>	<u>1846</u>
Ce.			
C.			
M.	<u>arm</u>	<u>3730</u>	<u>1852</u>
M.			
K.			
Mz.			
Me.			
V.	<u>3807</u>	<u>3810</u>	<u>1932</u>
S.	<u>3843</u>	<u>3851</u>	<u>1973</u>
S.			
A.	<u>3904</u>	<u>3903</u>	<u>2035</u>
R.			
PE.			
G.			
T.D.	<u>3945</u>		

Loc. in Sec. SE SE SW

Geol.

Contr.

Pool

NW St. John

ABANDONED

Date Comm. 7-1-55

JUL 20 1955

8" @ 162/165 DST 3493-3520 open 20 min

Rec. 15' mud 1145/20" DST 3652-70

open 1 hr. Rec. 30' mud 980/20"

D & A