
Stafford KANSAS

FORM SCM 25M 3-49 PETROL

Section 16 Township 23 Range 14W

Well No. #1 Beaver

Company Westgate-Greenland

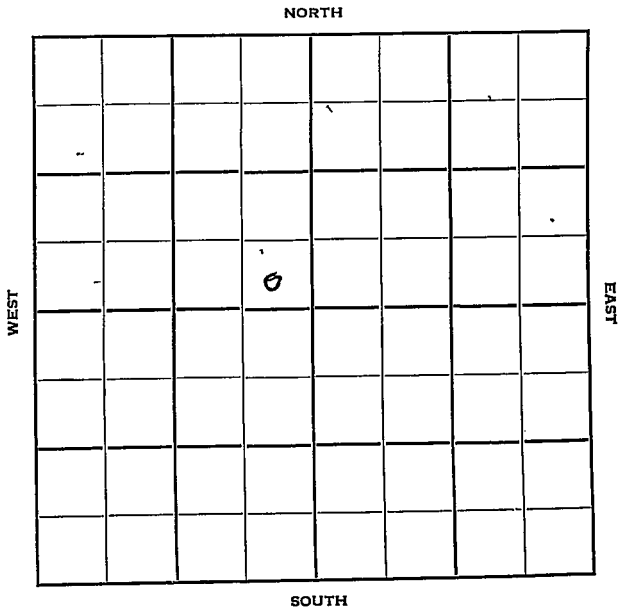

FORM 252-B
10M 8-51 TPCO.

Stafford KANSAS

Sec. 16 Twp. 23 R. 14 W

Well No. # 1 Beaver Farm

Westgate-Greenland Company

Contractor

Wildcat


Ft. from N. Line

330 Ft. from S. Line

330 Ft. from E. Line

Ft. from W. Line

SE SE NW

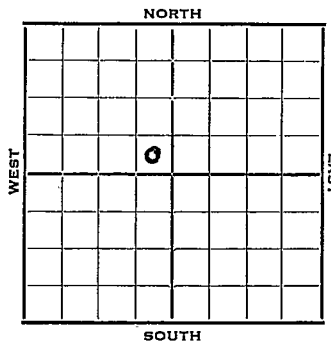

1952	Elev. 1954' DF REPORT
7/16	Spud 7-4-52 10" @ 201 Drlg. 3550' (tight hole)
7/23	Anhy 864 Heeb. 3395 Br Li 3524 Lans. 3540 DST 3655-69, 1 hr. 30' HOCM 240' muddy oil 1240# DST 3690-3714, 1 hr. 240' GCM 1320# DST 3729-39, 1 hr. 10' m 0# BKC 3776 Cong. 3800 V 3841 DST 3967-82, 1 hr. 85' O&GCM 360' gas 150# Arb. 4012 DST 4012-21, 1 hr. 860' O&GCM sulp wtr. est. 60% oil 60' sul. wtr. RTD 4042 7" @ 4041'
7/30	24/4006-12 SO 4010-12 fill up 320' oil & 3 galw S/35 BO 6 hrs.
8/6	NR

VER

OVER

O.W.W.O.

1952

8/13 Spud date 7-4-52 3841
Oil Well TD 4042 1954
10" @ 201 Anhy 864 1887
Heeb. 3395 Br Lime 3524
Lans. 3540
DST 3655-69 opn 1 hr. Rec. 30' hocm
240' muddy oil 1240#
DST 3690-3714 opn 1 hr. Rec. 240'
gcm 1320# DST 3729-39 opn 1 hr
Rec. 10' mud 0# BKC 3776
Cong 3800 Viola 3841
DST 3967-82 opn 1 hr. Rec. 85' o & gcm
360' gas 150# Arb. 4006
DST 4012-21 opn 1 hr. Rec. 860' O&
GCSW 60' sul wtr TD 4042
7" @ 4041 24/4006-12 FU 320' oil
3 gw S/35 bo 6 hrs.
Comp. 150 bopd 9% wtr.

COMPLETED

O.W.W.O.

1953

3/4 Lans 3540 Arb. 4011 OTD 4044 5" @ 4043
Perf.3655-71 1000A F/65 OPH 3 hrs.
POP

3/12 NR

3/19 NR

3/25 Oil Well
TD 4044
Lans 3540, Arb 4011,
OTD 4044
5" @ 4043
Perf 3655-71 1000A F/65 boph 3 hr/
Comp. 328 bopd

COMPLETED

FORM 275 FOR SALE BY KANSAS BLUE PRINT CO.


County Stafford State Kansas

Sec. 16 (Blk. Twp.) 23 (Sur. Rge.) 14W Map No.

Operator Westgate-Greenland

Well No. 1 Farm Beaver

Elev. 1954DF Location SE SE NW

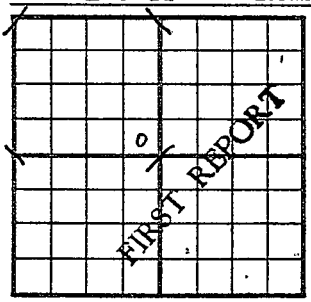

330 Ft. From S Line NW

330 Ft. From E Line Quarter

1st. Report JUL 6 1952

Completion

Remarks

Spudding Date 7-4-52

Drlg. Data Wildcat

10" @ 201 Drlg. 3550 tite hole

J. G. McGEHEE

FORM 275 FOR SALE BY KANSAS BLUE PRINT CO.


County Stafford State Kansas

Sec. 16 (Blk. Twp.) 23 (Sur. Rge.) 14W Map No.

Operator Westgate-Greenland

Well No. 1 Farm Beaver

Elev. 1954 Location SE SE NW

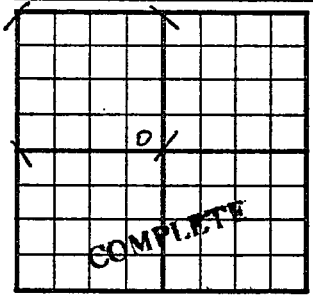

330 Ft. From S Line NW

330 Ft. From E Line Quarter

1st. Report

Completion AUG 13 1952

Remarks Wildcat

Spudding Date 7-4-52

Drlg. Data Oil well TD 4042

10" @ 201 Anhy 864 Heeb. 3395

Br. lime 3524 Lans. 3540 DST 3655-69

open 1 hr. Rec. 30' hocm 240' muddy oil

1240# DST 3690-3714 open 1 hr. Rec.

240' gcm 1320# DST 3729-39 open 1 hr.

Rec. 10' mud 0# B KC 3776 Cong. 3800

Viola 3841 DST 3967-82 open 1 hr. Rec.

85' o & gcm 360' gas 150# Arb. 4006

DST 4012-21 open 1 hr. Rec. 860' o & gc

sw 60' sul. water TD 4042 7" @ 4041

24/ 4006-12 FU 320' oil 3 gw S/ 35 bo

6 hr. Comp. 150 bopd 9% water

J. G. McGEHEE

FORM 275 FOR SALE BY KANSAS BLUE PRINT CO.

O.W.W.O.


County Stafford State Kansas

Sec. 16 (Blk. Twp.) 23 (Sur. Rge.) 14W Map No.

Operator Westgate-Greenland

Well No. 1 Farm Beaver

Elev. Location SE SE NW

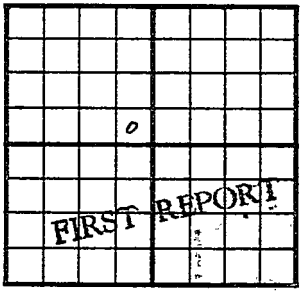

330 Ft. From S Line NW

330 Ft. From E Line Quarter

1st. Report MAR 4 1953

Completion O.W.W.O.

Remarks OWWO

Spudding Date

Drlg. Data

Lans. 3540 Arb. 4011 OTD 4044

5" @ 4043 Perf. 3655-71 1000 A

F/ 65 boph 3 hr. POP

J. G. McGEHEE

FORM 275 FOR SALE BY KANSAS BLUE PRINT CO.

O.W.W.O.


County Stafford State Kansas

Sec. 16 (Blk. Twp.) 23 (Sur. Rge.) 14W Map No.

Operator Westgate-Greenland

Well No. 1 Farm Beaver

Elev. 1954 Location SE SE NW

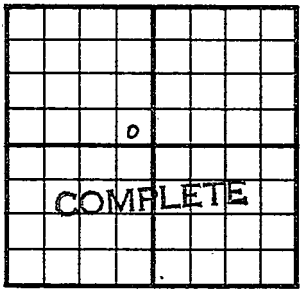

330 Ft. From S Line NW

330 Ft. From E Line Quarter

1st. Report

Completion MAR 25 1953

Remarks OWWO

O.W.W.O.

Spudding Date

Drlg. Data Oil well TD 4044

Lans. 3540 Arb. 4011 OTD 4044

5" @ 4043 Perf/ 3655-71 1000 A

F/ 65 boph 3 hr. Comp. 328 bopd

J. G. McGEHEE