


Stafford KANSAS

DX 78-1

Section 16 Township 23 Range 11W
 Well No. 1 Beaver
 Company Deep Rock

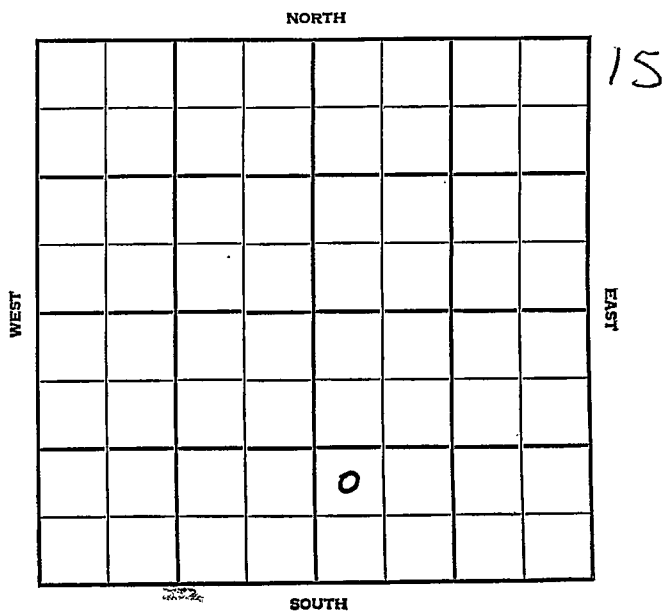

Stafford KANSAS

SEC.	TWP.	R.
16	23	11W

WELL NO.

1 Beaver

FARM

COMPANY

Deep Rock

CONTRACTOR

Gabber-Jones-
Grissman Pool

Ft. from N. Line


990

Ft. from S. Line

Ft. from E. Line

330


Ft. from W. Line

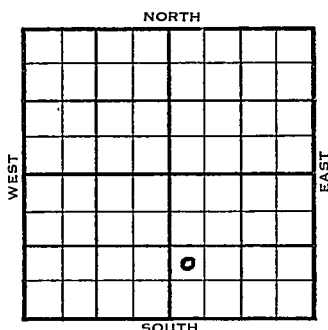

NW SW SE

	ELEVATION	REPORT
1954	1951	
7/28-	Spdg 7-26-54 Drlg. 190	
8-11	Spdg 7-26-54 D&A TD 4039 10" @ 249 Br.lime 3530 Lans. 3542 DST 3660-82 open 45 min. Rec. 100' mud 1100# Simp. 3973 DST 3979-94 open 1 hr. Rec. 85' ho & gem Arb. 4021 670# TD 4039 Schlumberger Tops Heeb 3396 Lans. 3542 BKC 3794 Viola 3897 Simp. sh. 3962 Simp. sd. 3973 Arb. 4019 TD 4044 D&A	
ABANDONED		

County Stafford State Kansas
 Sec. 16 (Blk.) 23 (Sur.) 14W Map No.
 Operator Deep Rock
 Well No. 1 Farm Beaver
 Elev. _____ Location NW SW SE

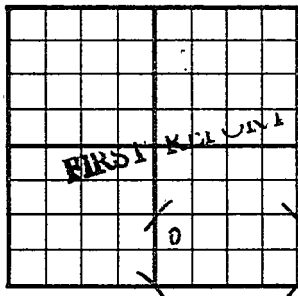


990 Ft. From S Line SE
330 Ft. From W Line Quarter
 1st. Report JUL 28 1954
 Completion _____
 Remarks Phillips farmout
Gabbert-Jones - Contr.
 Spudding Date 7-26-54

Drlg. Data

Grissman Pooldrlg. 190

J. G. McGEHEE

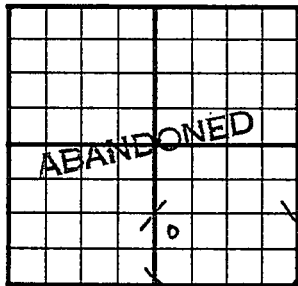County Stafford State KansasSec. 16 (Blk. 23 (Sur. 14W (Twp. Rge.) Map No.Operator Deep RockWell No. 1 Farm BeaverElev. 1951 Location NW SW SE990Ft. From S Line SE330Ft. From W Line Quarter

1st. Report

Completion AUG 11 1954Remarks Crissman PoolGabbert-Jones - Contr.Spudding Date 7-26-54Drlg. Data D & A TD 403910" @ 249 Br. lime 3530 Lans. 3542DST 3660-82 open 45 min. Rec. 100' mud1100# Simp. 3973 DST 3979-94 open 1 hr.Rec. 85' ho & gcm Arb. 4021 670# TL 4TD 4039 SCHLUMBERGER TOPSHeeb. 3396 Lans. 3542 B KC 3794Viola 3897 Simp. sh. 3962 Simp. sd. 3973Arb. 4019 TD 4044D & A