

Section 16 Township 23 Range 14 WWell No. # 3 CrissmanCompany Westgate-Greenland

NORTH

WEST

EAST

0

SOUTH

13

Sec. **16** Twp. **23** R. **11W**Well No. **#3 Crissman** Farm**Westgate-Greenland** Company

Contractor

Ft. from N. Line

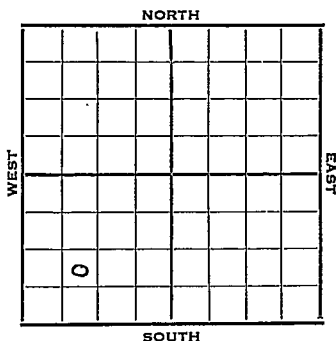
990

Ft. from S. Line

Ft. from E. Line

990

Ft. from W. Line

NE SW SW**1952****Elev. 1974'****R E P O R T****8/27****MI****9/3****8" @ 248****Drlg. 3511****9/10****Heeb. 3405 Tor 3424 Douglas 3440****Br Li 3539 Lans. 3549****DST 3670-80 1 hr. 800' oil 1250#****DST 3735-53 1/4 hr. F oil in 12"****1510# FP 1295 BKC 3784****Miss 3853 V 3920 Simp 3922****DST 3991-4012 1 hr. HO&GCM****9/17****Arb. 4033****RTD 4073****5" @ 4062'****9/24****CO 83/3737-53 P/100 BO 24 hrs.****10/1****Spud 8-26-52****Oil Well TD 4073'****8" @ 248' Heeb. 3405 Tor. 3424****Doug. 3440****Br Li 3539****Lans. 3549****DST 3670-80 open 1 hr. rec. 800' oil 1250#****DST 3735-53 open 1/4 hr. F/ oil in 12 min. 1510# B KC 3784****Miss. 3853 Viola 3920 Simp. 3972****DST 3991-4012 open 1 hr. rec. 60'****HO&GCW & M Arb. 4033 TD 4073****5" @ 4062 83/ 3737-53 P/ 100 bo 24 hr****Comp. BHB F/ 3000 bopd****COMPLETED****3920
1974
1946**

