


Section 16 Township 23 Range 15-W

Well Number 1 Wallace

Company Kessler & Their et al

SPECIAL

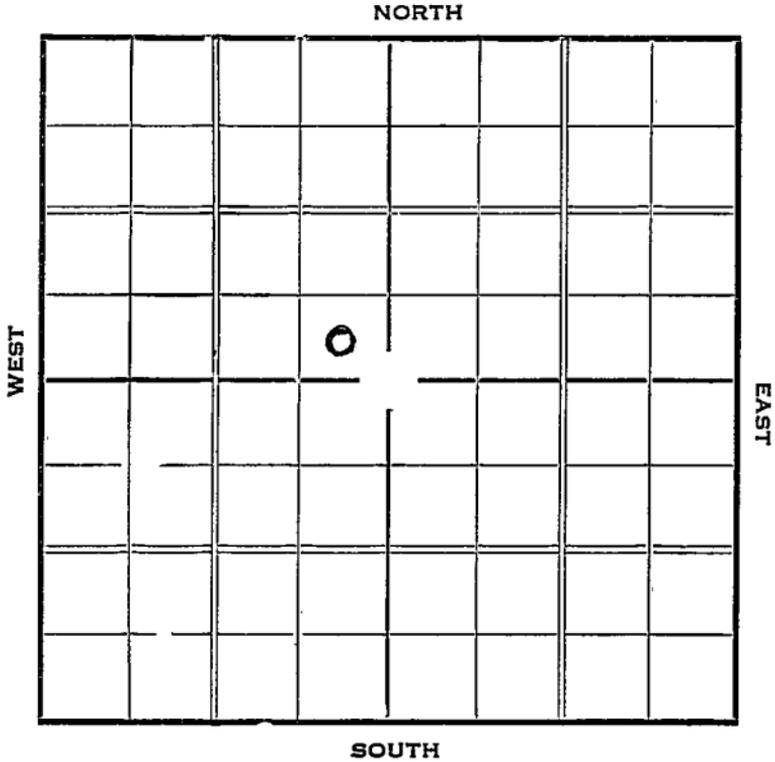

KANSAS

Pawnee

Map No. Sec. 16 Twp. 23 R. 15W

Well No. 1 Wallace Farm


Kessler & Their et al Company

..... Ft. from N. Line

330 Ft. from S. Line

330 Ft. from E. Line

..... Ft. from W. Line

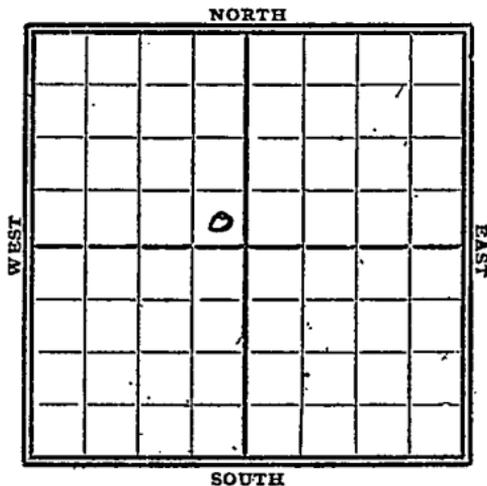

SPECIAL

Date	Elev.	REPORT
1936	2031	
12-9	R.O.G.	
12/17	Rigging up	
12/24	Drlg. 400'	
12/29	12" @ 545'. Drlg. 590'.	
1937		
1/7	Drlg. 2215'.	
1/14	Drlg. 2955'.	
1/21	K. C. L. 3659'. Coring 3752'.	
1/28	Viola 4005'. Simpson 4090'.	
	Sil. 4168'. Coring 4190'.	
2/3	Sil. 4168'. Water.	
	T. D. 4200'.	
	ABANDONED	

KANSAS

Map No. 83 Sec. 16 Twp. 23 R. 15W.

Well No. 1 Wallace

Kessler & Their & Co. Company

Contractor

Special

SECTION PLAT

_____ Ft. from N. Line

330 Ft. from S. Line

330 Ft. from E. Line

_____ Ft. from W. Line

FIRST REPORT

Location _____

Rig up _____

Drilling and Remarks:

ROG.

RECORD

Cased _____ in., _____ ft.

Sand _____

Gas _____

Oil _____

Total Depth _____

PRODUCTION

1st 24 hrs. Nat. _____

1st 24 hrs. after shot _____

Gas _____ Cu. Ft.

Dry Hole _____

Abandoned _____

Date

DEC 9 1936 19

S. J. LEWIS Scout

Map No. 83 Sec. 16 Twp. 23 R. 15W

Well No. 1 Wallace

Kessler & Their & Co. Company

Contractor

SECTION PLAT

		0	

_____ Ft. from N. Line

330 Ft. from S. Line

330 Ft. from E. Line

_____ Ft. from ⁶W. Line

ABANDONED

Location _____

Rig up _____

Drilling and Remarks:

Sil 4168

water

II & A

RECORD

Cased _____ in., _____ ft.

Sand _____

Gas _____

Oil _____

Total Depth 200

PRODUCTION

1st 24 hrs. Nat. _____

1st 24 hrs. after shot _____

Gas _____ Cu. Ft.

Dry Hole _____

Abandoned _____

Date

FEB 3 1937 19

S. J. LEWIS Scout