

Pawnee


KANSAS

DX 78-1

Section 16 Township 23 Range 17W

Well No. #3 Fergus "A"

Company Hilton Drlg.

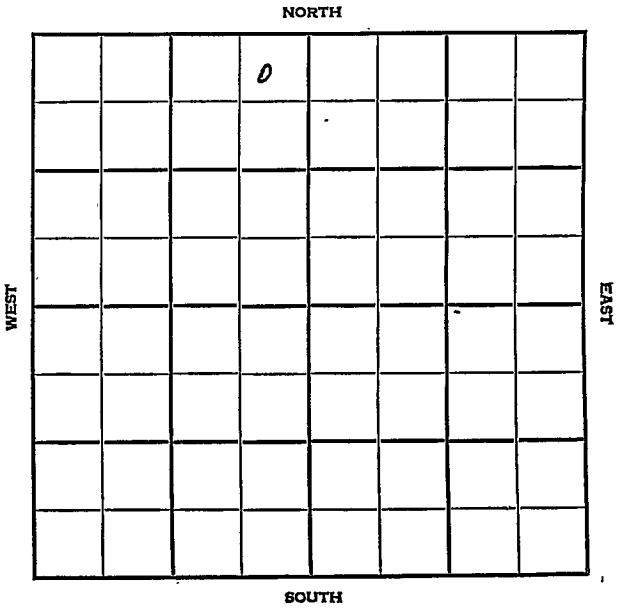

Pawnee

KANSAS

SEC.	TWP.	R.
16	23	17 W

WELL NO.

3 Fergus "A"

FARM

COMPANY

Hilton Drlg.

CONTRACTOR

Co. tools
Garfield Pool


330 _____ Ft. from N. Line

_____ Ft. from S. Line

330 _____ Ft. from E. Line

_____ Ft. from W. Line

NE NE NW

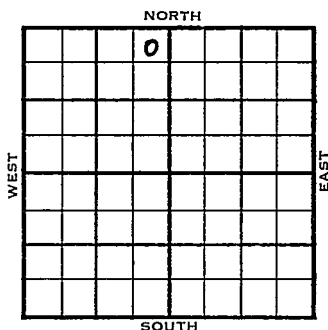

1955

ELEVATION

2095'

REPORT

3/2 Spud 2-27-55
8" @ 225 WOC

4/13 Spud 2-27-55 - OilWell
TD 4390'
8" @ 2 25'
Heeb. 3678', Br lime 3788', Lans. 3796'
Cong. 4248'
DST 4232-65', gas in 3", oil in 37",
1282#
Miss. 4274'
DST 4274-95', opn 1½ hrs., rec. 80'
ocm, 150#
DST 4326-56, opn 1½ hrs., rec. 330'
O&GCM, 30' swo&gcm, 940#
TD 4390'
5" @ 4389'
48/4256-64, frac, 300A
F/47 b oph
Comp. BHB 3000 bopd

COMPLETED

