


Section 16 Township 23 Range 17W

Well No. 2 Fergus "B"

Company Hilton Drig. & Sunray Mid-Continent

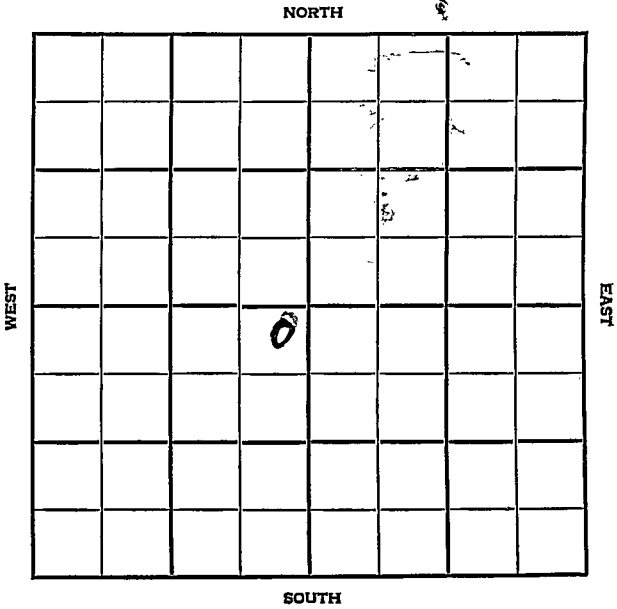

//

HOT FILE Pawnee KANSAS

SEC. 16 TWP. 23 R. 17W

WELL NO. 2 Fergus "B" FARM

COMPANY HILTON DRIG & SUNRAY MID-CONTINENT (Development-OBOG)

CONTRACTOR Co. Tools


Garfield

330 Ft. from N. Line

Ft. from S. Line

330 Ft. from E. Line

Ft. from W. Line

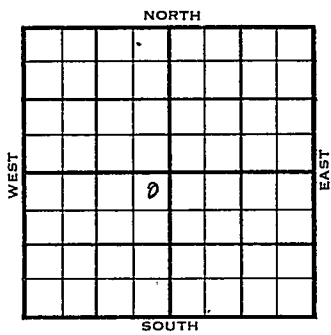

NE NE SW
Int.

	ELEVATION	REPORT
1955	2101'	
6/29	M I R	(F.R. Ticket)
7/1	8-5/8" @ 220'	(DR)
7/5	Spud 6-27-55	
	Drlg. 3645'	"
7/6	Drlg. 3850'	"
7/7	" 4025	
7/8	" 4191'	
7/11	WOC 5 1/2" casing 4358 DST 4268-86 open 1 hr Rec 118 very slight oil cut mud - BHFP 56# BHP 204# in DST TD 4248' open 1 hr gas to surface in 2 min gauged 1500 MCF/d rate Rec 100' frothy oil - 470' clean oil BHFP 262# BHP 1190#	
7/12	T.D. 4350'	
7/13	Bailing 4350'	
7/14	Perf 4243-48 " 4254-58 Prep to sand frac	
7/15	Sand frac and testing	
7/18	T.D. 4350 Flowed 168 bbls day rate 1/4" ck CP 410 TPO	

7/19 Flowed 168 bbls day rate - 1/4"
Ck CP 410 TP O#

Completed

7/22 CO 30/4243-48, 24/4254-58, 300A, frac
F/7 boph

7/28 Heeb. 3675, Br. Lime 3781, Lans 3790,
Cong. 4215, Cong ch. 4231, Miss. 4271,
Meisner 4321, TD 4350.

8/3 ComP: F/135 bopd

H.	3675	1574
BL	3781	1680
L.	3790	1689
U	4215	2114
Cong ch.	4231	2130
K.	4271	2170
Mz	4321	2220
TD.	4350	

COMPLETED

County Pawnee Elev. _____
 Sec. 16 Twp. 23 Rge. 17W
 Company Hilton Drig. & Sunray Mid-Continent
 FarmName Fergus "B" No. 2

Co.

TOPS	DEPTH	LOG	DATUM
Anh.			
TP.			
H.			
Tr.			
Dg.			
BL.			
L.			
K.C.			
B.K.C.			
Ce.			
C.			
M.			
M.			
K.			
Mz.			
Mc.			
V.			
S.			
S.			
A.			
R.			
PE.			
G.			
TD.			

Loc. in Sec. NE NE SW

Geol. _____
 Contr. _____
 Co. tools _____

Pool Garfield

FIRST REPORT
 JUN 29 '55

Lse.

No.

Sec.

T.

R.

Date Comm. M I R

NA

County Pawnee Elev. 2101
 Sec. 16 Twp. 23 Rge. 17W
 Company Hilton Drlg. & Sunray Mid-Continent
 Farm Name Fergus "B" No. 2

TOPS	DEPTH	LOG	DATUM	Loc. in Sec.						
Anh.				NE NE SW						
TP.										
H.	3675		1574							
Tr.										
Dg.										
Bl.	3781		1680							
L.	3790		1689	Geol.						
K.C.										
B.K.C.				Contr.						
Ce.										
C.	4215		2114	Co. tools						
M. Cong ch.	4231		2130	Pool <u>Garfield</u>						
M.	4271		2170							
K.										
Mz.	4321		2220							
Me.										
V.										
S.										
S.										
A.										
R.										
PE.										
G.	IFE		2142-47	<table border="1"> <tr> <td colspan="2">COMPLETE</td> </tr> <tr> <td>0</td> <td></td> </tr> <tr> <td></td> <td></td> </tr> </table>	COMPLETE		0			
COMPLETE										
0										
	5 1/2		2247							
TD.	4350		2249							

Date Comm. 6-30-55 AUG 3 1955
 8 5/8" @ 220/200 DST 4213-48 open
 1 hr. gas in 2 min. 1,500 mcfg
 Rec. 100' froggy oil 470' clean oil
 1190/30" DST 4268-86 open 1 hr.
 Rec. 118' vsocm 204/30" 5 1/2" @ 4348
 CO 30/ 4243-48 24/ 4254-58 300 A
 frac F/ 7 boph Comp. F/ 135 bopd
 7-1-55 160 1/4