

DX 78-1


Pawnee

KANSAS

Section 16 Township 23 Range 17 W

Well No. # 2 Fertig

Company Peel-Hardman & Zoller

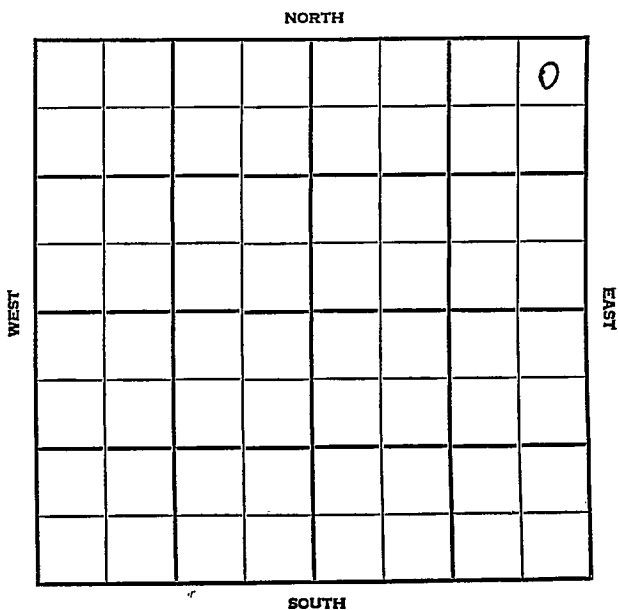

Pawnee KANSAS

SEC. 16	TWP. 23	R. 17W
------------	------------	-----------

WELL NO. 2 Fertig FARM

COMPANY Peel-Hardman & Zoller


CONTRACTOR Glenn Peel  
Garfield Pool

440 Ft. from N. Line

Ft. from S. Line

440 Ft. from E. Line

Ft. from W. Line

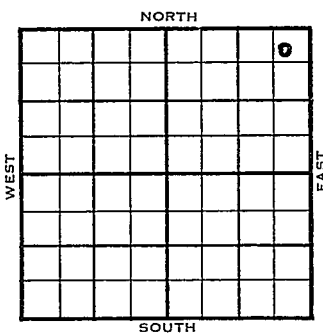

NE NE NE

1955	ELEVATION 2097'	REPORT
------	--------------------	--------

3/16  
 S pud 3-12-55  
 8" @ 217'  
 D rlg. 1532'

County Pawnee State Kansas

Sec. 16 (Blk. Twp.) 23 (Sur. Rge.) 17W Map No.

Operator Peel-Hardman & Zoller

Well No. 2 Farm Fertig

Elev. 2097 Location NE NENE


440 Ft. From N Line NE

440 Ft. From E Line Quarter

lst. Report MAR 16 1955

Completion \_\_\_\_\_

Remarks \_\_\_\_\_

Glenn Peel - Contr.

Spudding Date 3-12-55

Drig. Data Garfield Pool

8" @ 217 drig. 1532