


Section 16 Township 23 Range 33 W

Well No. # 1 Johnson

Company Champlin Ref.

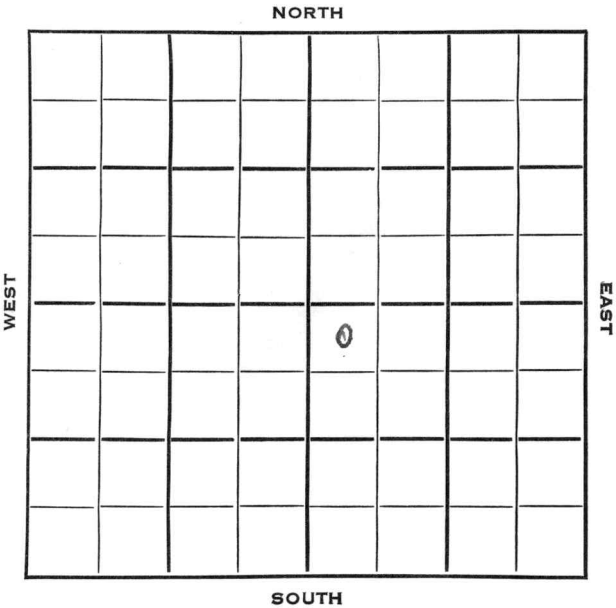

Finney

KANSAS ✓

Sec. 16 Twp. 23 R. 33WWell No. #1 Johnson Farm

Champlin Ref.

Company

Contractor

Hugton Pool


330 Ft. from N. Line

Ft. from S. Line

Ft. from E. Line

330 Ft. from W. Line

NW NW SE

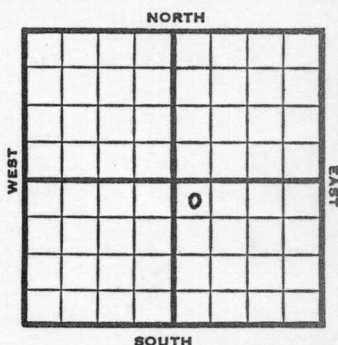

1953 Elev. 2904' REPORT

7/1 Location

7/8 "

7/22 10" @ 378' w/300 sks
 RTD 2662'
 7" @ 2662'

7/29 Her 2560' Kr 2586 Win 2622
 CO 2634 48/2608-20' 24/2582-88'
 112/2624-52' 2000 A Plug 2614
 56/2564-78 60/2589-2604
 Packer 2583' 4000 A

8/5 N.R.

8/19 CO 2662'

8/26 NR

10/7 Spud 7-7-53

Gas Well

TD 2662'

10" @ 378'

Her. 2560', Kri 2586, Win 2622,

TD 2662'

7" @ 2662'

CO to 2634

48/ 2608-20

24/ 2582-88, 112/ 2624-52

2000 A

SP 2614

56/ 2564-78


OVER

1953

Information brought forward.

10/7 60/ 2589-2604 SP 2583 4000 A
2000 A CO to 2662
Comp 5,180,000 gas

COMPLETED

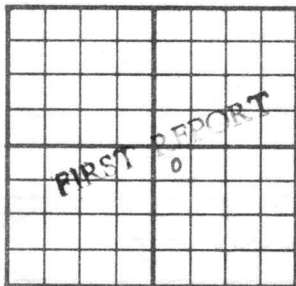
County Finney State KansasSec. 16 (Blk. Twp.) 23 (Sur. Rge.) 33W Map No.Operator Champlin Ref.Well No. 1 Farm JohnsonElev. Location NW NW SE330 Ft. From N Line SE330 Ft. From W Line Quarter1st. Report JUL 1 1953

Completion

Remarks

Spudding Date

Drig. Data Hugoton PoolLocation

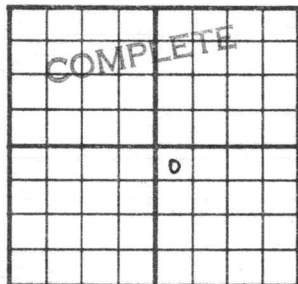County Finney State KansasSec. 16 (Blk.
Twp.) 23 (Sur.
Rge.) 33W Map No.Operator Champlin Ref.Well No. 1 Farm JohnsonElev. 2904 Location NW NW SE330 Ft. From N Line SE330 Ft. From W Line Quarter

1st. Report

Completion OCT 7 1953Remarks Hugoton PoolSpudding Date 7-7-53Drlg. Data Gas well TD 266210" @ 378 Her. 2560 Kri. 2586Win. 2622 TD 2662 7" @ 2662CO to 2634 48/ 2608-20 24/ 2582-882112/ 2624-52 2000 A SP 2614 56/ 2564-78 60/ 2589-2604 SP 2583 4000 A2000 A CO to 2662 Comp. 5,180,000 gas

J. G. McGEHEE