

Finney


KANSAS

SECTION 16 TOWNSHIP 23 RANGE 34W

WELL NO. #6 Garden City "C"

COMPANY Champlin Ref. Co.

NORTH

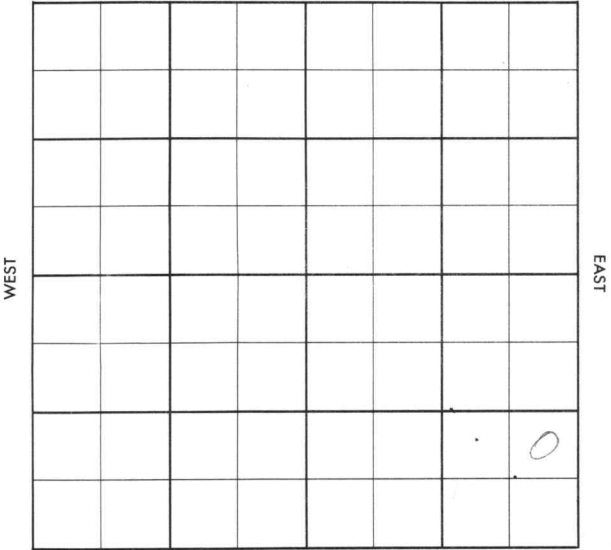

SOUTH

County Finney Elev. _____
Sec. 16 Twp. 23 Rgs. 34W
Company Chaplin Ref. Co.
FarmName Garden City "C" No. 6

TOPS	DEPTH	LOG	DATUM	Loc. in Sec.
Anh.				NE SE SE
Tp.				
H.				
Tr.				
Dg.				
BL.				
L.				Geol.
K.C.				Contr.
B.K.C.				Hartmann & Hart-
Ce.				man Tools
C.				Pool
M.	5070			Sequoyah
M.				
K.				
Mz.				
Ma.				
V.				
S.				
S.				
A.				
R.				
Pe.				
G.				
T.D.				

Date Comm. _____ FIRST REPORT
Location OCT 10 '56

[Handwritten: 525]

[Handwritten: OCT 5 1956]

[Handwritten: R.G.R.]

County Finney Elev. 2954 DF
 Sec. 16 Twp. 23 Rge. 34W
 Company Champlin Ref. Co.
 Farm Name Garden City "C" No. 6

TOPS	DEPTH	LOG	DATUM	Loc. in Sec.
Anh.				NE SE SE
TP.				
H.	3775			
Tr.	3789			
Dg.				
BL.				
L.	3821	3819		Geol.
K.C.				
B.K.C.	4282	4282		Contr.
Ce.	Mardi 4300	4299		Hartmann & Hart-
C.e.	4428	4427		man Tools
M.	5070			Pool
M.	MWD 4626	4630		
K.	" 2d 4631-38	4632-36		Sequoyah
Mz.	" 3d 4662-67	4644-46		
Mo.	" 3d	4657-74		
V.	ST 617 4679	4679		
S.	ST 6013 4826	4824		
S.	SPUR 5021			
A.				
R.				
PE.				
G.				
TD.	5030			

COMPLETE
 DEC 26 '56

Date Comm.

Location OCT 17 '56 OCT 24 '56 10-19-56

8 3/8 427/300 @ 2245 96.31 '56

@ 3800 NOV 7 '56 DST 4572-4658 1hr

rec 90' Md rec 120' 9554 Md

No press DST 4569-4658 NOV 13 '56

ops 2 hrs rec 1535' 56 CM No press

DST 4552-4658 1hr rec 630'

Md. no press DST 4624-58

2 hrs rec 90' 0 CM + 180' MCO

+ 450' gssy oil FP 120-225
 BHP 1070/20" DST 4663-80
 2 hrs rec P' 30 CM no press
 DST 4663-80 2 hrs rec 70'
 OCM + 270' gssy MCO FP 80-170
 BHP 890/20" DST 4915-67
 2 hrs rec 35' md FP 20-40
 BHP 680/20" NOV 21 '56 5 1/2 4740/900
 NOV 28 '56 CO 4706 12/4632-35
 20/4644-49 88/4657-79 1 1/2
 Frac 21 x 2, DEC 1 '56 Pop Pld.
 DEC 12 '56 P 35 B0 24 hrs 640
 B5 & W P 33 B0 24 hrs 6000
 B0 & W DEC 19 '56 S.I. 48 hrs st
 tst P. 48 Bopd + Tr. wtr.
 DEC 26 '56 gas 30.5°
 complete

16-23-34

ne-se-se