


Section 16 Township 23 Range 38W

Well No. 1 Johnson
Gottlob

Company Kansas-Nebraska

Hugoton

NORTH

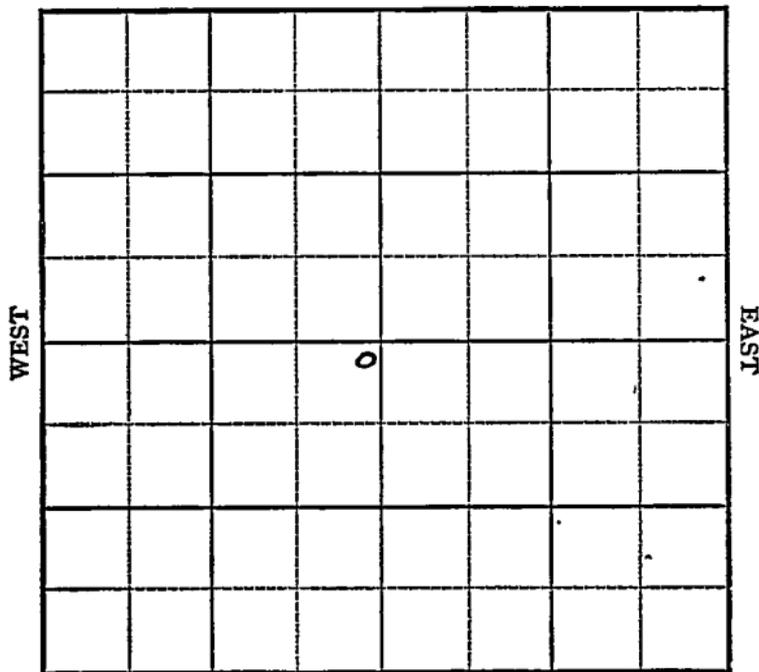

SOUTH

Sec. 16 Twp. 23 R. 38W ✓

Well No. #1 ~~Johnson~~ Gottlob Farm

Kansas-Nebraska Company

Hugoton Pool


100' Ft. from N. Line

_____ Ft. from S. Line

100' Ft. from E. Line

_____ Ft. from W. Line

NE SW

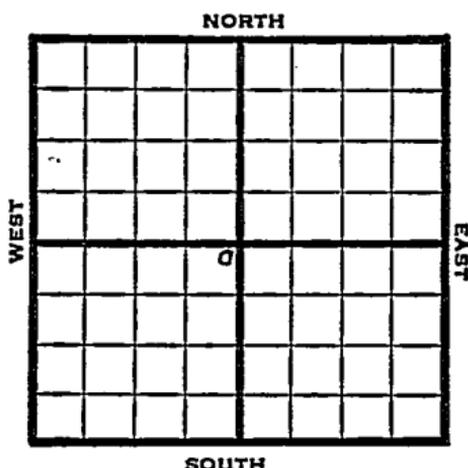

1949

Elev 3362'

REPORT

1/12	Location
1/19	"
1/26	"
2/2	"
2/9	"
2/16	"
2/23	8" @ 607' Drlg. 2675'
3/2	Herington 2609' Krider 2617' Winfield 2661' Ft. Riley 2754' 2793 Run 7"
3/8	7" @ 2793'
3/16	"
3/23	"
3/29	60 shots 2662-79 squeeze 15 " 2664-69 - 4000 acid S Gas & W
4/6	"
4/12	"
4/20	"
4/27	"
5/4	"
5/10	"
5/18	"
5/25	"
6/1	"

OVER

1949

6/7 60 shots 2662-70
wb 15 shots 2664-69-
4000 acid
S Gas & W

6/15 7"@ 2793'
TD 2793'
Perf 20000 acid
255,000 Gas
428# R Pr
Comp.

COMPLETED

Kansas

Map No. _____ Sec. 16 Twp. 23 R. 38W

Well No. 1 Johnson

Kansas - Nebraska

Company _____

FIRST REPORT

Contractor _____

NE SW

SECTION PLAT

100 Ft. from N. Line

_____ Ft. from S. Line

100 Ft. from E. Line

_____ Ft. from W. Line

Kearny County

RECORD

Location X

Cased _____ in., _____ ft.

Rig up _____

Sand _____

Drilling and Remarks:

Gas _____

Oil _____

Total Depth _____

PRODUCTION

1st 24 hrs. Nat. _____

1st 24 hrs. after shot _____

Gas _____ Cu. Ft.

Dry Hole _____

Abandoned _____

Date

JAN 1 2 1949 19

S. J. LEWIS Scout

Map No. _____ Sec. 16 Twp. 23 R. 38W

Well No. 1 Gottlob

Kansas-Nebraska Company

CORRECTION Contractor

NE SW

SECTION PLAT

100 Ft. from N. Line

_____ Ft. from S. Line

100 Ft. from E. Line

_____ Ft. from W. Line

Kearny County

RECORD

Location _____

Cased _____ in., _____ ft.

Rig up _____

Sand _____

Drilling and Remarks:

Gas _____

Oil _____

Reported as

Total Depth _____

#1 Johnson

PRODUCTION

1st 24 hrs. Nat. _____

1st 24 hrs. after shot _____

Gas _____ Cu. Ft.

Dry Hole _____

Abandoned _____

Date

MAR 9 1949 19

S. J. LEWIS Scout

Kearny County Kansas State

Map No. ✓ Sec. 16 Twp. 23 R. 38W

Well No. 1 Gottlob

Kansas - Nebraska Company

COMPLETE

Contractor

NE SW

E1.3262
SECTION PLAT

100 Ft. from N. Line

 Ft. from S. Line

100 Ft. from E. Line

 Ft. from W. Line

Hugoton Pool

Remarks:

7" @ 2793

7" @ 2793

Perf.

20000 acid

255,000 gal

425" R/P

Date

Scout

JUN 15 1949