


KANSAS,

Kearny

Section 16 Township 23 Range 36W

Well No. 1 Klebman

Company Black-Marshall

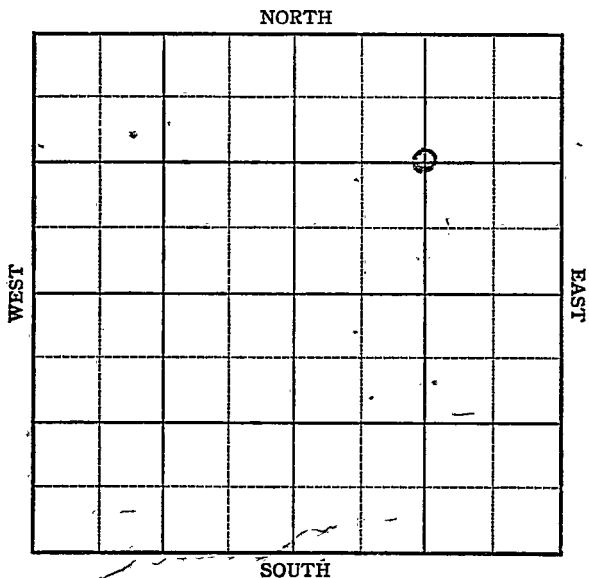

KANSAS

Kearney county

Sec. 16 Twp. 23 R. 36W

Well No. 1 Kleeman Farm
Black-Marshall Company

Hugoton Pool

1320 Ft. from N. Line


Ft. from S. Line

1320

Ft. from E. Line

Ft. from W. Line

C NE

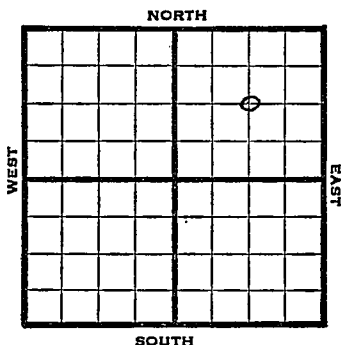

1947

REPORT

5/7

Location

5/14

Location Abandoned.

ABANDONED

This well is to be drilled another test has been sent in Sam

KANSAS

Kearney county

Sec. 16 Twp. 23 R. 36W

Well No. 1 Klebman Farm

Black-Marshall et al Company

Hugoton pool

1320 Ft. from N. Line


Ft. from S. Line

1320

Ft. from E. Line

Ft. from W. Line

C NE

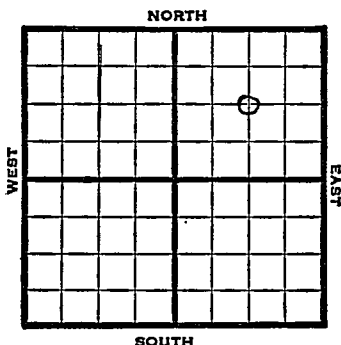

1947

Elev. 3165'

REPORT

5/28

Location

6/3

"

6/10

"

6/18

Location Abandoned.

ABANDONED

Map No. _____ Sec. 16 Twp. 23 R. 36WWell No. 1 KleemanBlack-Marshall

Company

FIRST REPORT

Contractor

C NE


SECTION PLAT

1320 Ft. from N. Line

_____ Ft. from S. Line

1320 Ft. from E. Line

_____ Ft. from W. Line

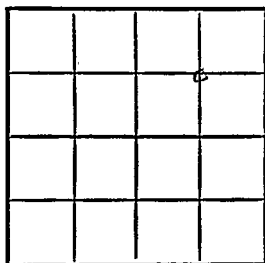Kearny CountyLocation X

Rig up _____

Drilling and Remarks: _____

RECORD

Cased _____ in, _____ ft.

Sand _____

Gas _____

Oil _____

Total Depth _____

PRODUCTION

1st 24 hrs. Nat. _____

1st 24 hrs. after shot _____

Gas _____ Cu. Ft.

Dry Hole _____

Abandoned _____

Date

MAY 7 1947

19

S. J. LEWIS

Scout

Kansas Hugoton Pool

Map No. _____ Sec. 16 Twp. 23 R. 36WWell No. 1 KleemanBlack-Marshall Company**ABANDONED** Contractor

C NE


SECTION PLAT

1320 Ft. from N. Line

_____ Ft. from S. Line

1320 Ft. from E. Line

_____ Ft. from W. Line

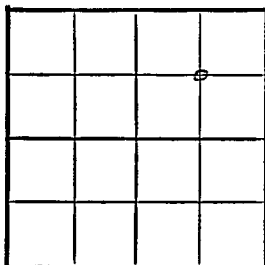Kearny County

Location _____

Rig up _____

Drilling and Remarks:

RECORD

Cased _____ in., _____ ft.

Sand _____

Gas _____

Oil _____

Total Depth _____

PRODUCTION

1st 24 hrs. Nat. _____

1st 24 hrs. after shot _____

Gas _____ Cu. Ft.

Dry Hole _____

Abandoned _____

Date

MAY 14 1947

19

S. J. LEWIS Scout

Map No. _____ Sec. 16 Twp. 23 R. 36W

Well No. 1 Klebman

Black-Marshall et al. Company

FIRST REPORT

Contractor

C NE


SECTION PLAT

1320 Ft. from N. Line

_____ Ft. from S. Line

1320 Ft. from E. Line

_____ Ft. from W. Line

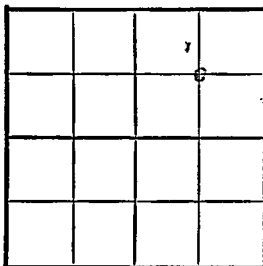

Kearny County

Location X

Rig up _____

Drilling and Remarks:

RECORD

Cased _____ in., _____ ft.

Sand _____

Gas _____

Oil _____

Total Depth _____

PRODUCTION

1st 24-hrs. Nat. _____

1st 24 hrs. after shot _____

Gas _____ Cu. Ft.

Dry Hole _____

Abandoned _____

Date

MAY 28 1947 19 _____ S. J. LEWIS Scout


Map No. 0 Sec. 16 Twp. 23 R. 36WWell No. 1 KlebmanBlack-Marshall et al. Company**ABANDONED**

Contractor

C NE

E1/8/65

SECTION PLAT

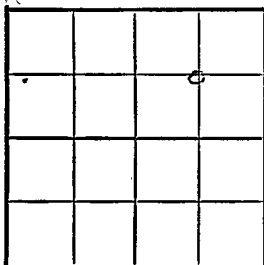1320 Ft. from N. Line Ft. from S. Line1320 Ft. from E. Line Ft. from W. LineKearny CountyLocation ✓Rig up

Drilling and Remarks:

RECORD

Cased in., ft.Sand Gas Oil Total Depth

PRODUCTION

1st 24 hrs. Nat. 1st 24 hrs. after shot Gas Cu. Ft.Dry Hole Abandoned

Date

JUN 1 8 1947₁₉S. J. LEWIS Scout