

# State Geological Survey

1-23-17W

AFFIDAVIT AND COMPLETION REPORT WICHITA BRANCH

ACO-1

This form must be filed in triplicate with the Kansas Corporation Commission, 200 Colorado Derby Building, Wichita, Kansas 67202, within five days after the completion of the well, regardless of how the well was completed. Circle one: Oil, gas, dry, SWD, OWWO, injection. Please type. Complete ALL sections. Applications must be filed for dual completion, commingling, salt water disposal and injection. Attach wireline logs (i.e. electrical log, sonic log, gamma ray neutron log, etc.) KCC#-(316) 263-3238.

OPERATOR LEBSACK OIL PRODUCTION, INC. API NO. 15-145-20,872

ADDRESS Box 489 - Hays, Kansas 67601 COUNTY Pawnee

FIELD \_\_\_\_\_

\*CONTACT PERSON Rex Curtis LEASE White

PHONE 913-625-3046

PURCHASER \_\_\_\_\_ WELL NO. 1

ADDRESS \_\_\_\_\_ WELL LOCATION NW/4

1320 Ft. from North Line and

370 Ft. from West Line of

the NW/4 SEC. 1 TWP. 23S RGE. 17W

DRILLING CONTRACTOR Sterling Drilling Company

ADDRESS Box 129 - Sterling Kansas


PLUGGING CONTRACTOR Sterling Drilling Company

ADDRESS Box 129 - Sterling, Kansas

TOTAL DEPTH 4260' PBTD \_\_\_\_\_

SPUD DATE 11/19/81 DATE COMPLETED 11/25/81

ELEV: GR2058 DF KB 2068

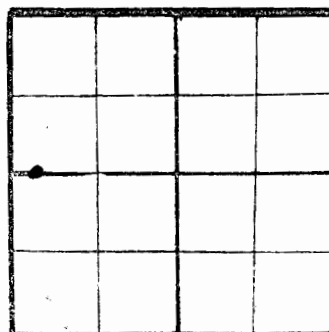

WELL PLAT  
(Quarter)  
or (Full)  
Section -  
Please  
indicate.

*KSS* ✓

DRILLED WITH (CABLE) (ROTARY) (AIR) TOOLS  
Report of all strings set — surface, intermediate, production, etc. (New)/(Used) casing.

Purpose of string	Size hole drilled	Size casing set (in O.D.)	Weight lbs./ft.	Setting depth	Type cement	Sucks	Type and percent additives
Surface	12-3/4"	8-5/8"	#24	257 K.B.	60/40 Poz.	200	3% cc

LINER RECORD			PERFORATION RECORD		
Top, ft.	Bottom, ft.	Sacks cement	Shots per ft.	Size & type	Depth interval

TUBING RECORD		
Size	Setting depth	Packer set at

ACID, FRACTURE, SHOT, CEMENT SQUEEZE RECORD	
Amount and kind of material used	Depth interval treated