

X✓

WELL LOG BUREAU—KANSAS GEOLOGICAL SOCIETY  
508 East Murdock, Wichita, Kansas


17-23-17W

Company- HILTON DRG. CO., INC.  
Farm- Hutchinson Estate No. 9  
"A"

SEC. 17 T. 23 R. 17W  
C W<sup>1</sup>/<sub>2</sub> SW NE

Total Depth. 4366'  
Comm. 9-12-56 Comp. 9-26-56  
Shot or Treated.  
Contractor. Hilton Drlg. Co., Inc.  
Issued. 4-6-57

County Pawnee  
KANSAS

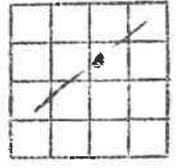

Elevation. 2100' DE

Production. Dry

CASING:

8 5/8" 224' w/200 sx cem  
1 1/2" 4356' w/150 sx cem.

Figures indicate Bottom of Formations.

sand	50	
clay	70	
sand-shale	150	
shale	224	
shale-shells	375	
red bed-sand	600	
sand	665	
red bed	1125	
Anhydrite	1150	
shale	1160	
shale-shells-red bed	1560	
shale-shells	1858	
shale-lime	2135	
lime-sand	2250	
lime	2660	
shale-lime	3435	
lime	3675	
shale-lime	3775	
lime	4217	
lime-shale-chert	4250	
chert-lime	4260	
chert-shale	4314	
chert-lime-shale	4360	RTD
chert-lime-shale	4366	
Total Depth		
TOPS: Scout		
Heebner	3678	
Brown lime	3775	
Lansing	3794	
shaley conglomerate	4219	
chert conglomerate	4235	
Mississippi	4246	
Misener	4310	

Pawnee

KANSAS

SECTION 17

TOWNSHIP 23

RANGE 17W

SECTION 17 TOWNSHIP 23 RANGE 17W


WELL NO. #9 Hutchinson "A"

WELL NO. #9 Hutchinson "A"

COMPANY Hilton Drlg.

COMPANY Hilton Drlg.

NORTH

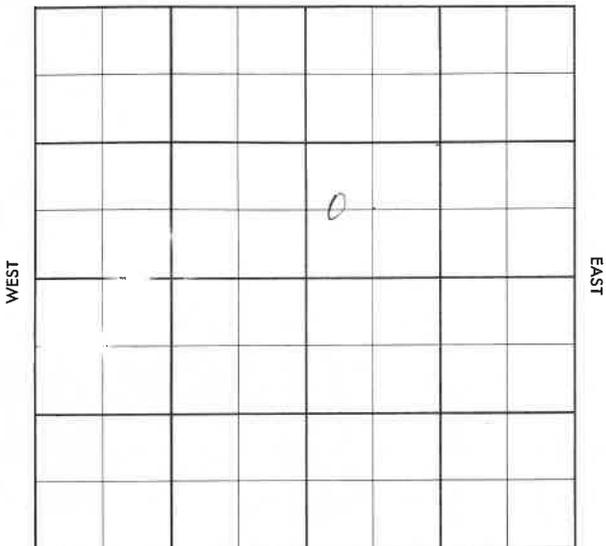

SOUTH

Pawnee

KANSAS

SEC.

17

TWP.

23

R.

17W

WELL NO.

#9 Hutchinson "A"

FARM

COMPANY

Hilton Drlg

CONTRACTOR

Co Tools

FT. FROM N. LINE

600


FT. FROM S. LINE

FT. FROM E. LINE

330

FT. FROM W. LINE

NORTH

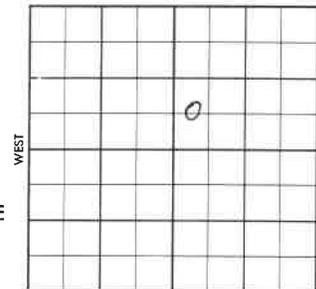

SOUTH

C W/2 SW NE

ELEVATION

1956

REPORT

9-12

MIR

FORM 504-5 SUNRAY

FORM 504-3 SUNRAY

County Pawnee Elev. \_\_\_\_\_  
 Sec. 17 Twp. 23 Rge. 17W  
 Company Hilton Drlg.  
 FarmName Hutchinson "A" No. 9

TOPS	DEPTH	LOG	DATUM	Loc. in Sec.
Anh.				<u>C W 1/2 SW NE</u>
Hp.				
H.				<u>600' SL</u>
Tr.				<u>330' WL</u>
Dg.				
Bl.				
L.				
K.C.				Geol. _____
B.K.C.				Contr. _____
Ce.				<u>Co. tools</u>
C.				Pool <u>Garfield</u>
M.				
M.				
K.				
Mz.				
Ma.				
V.				
S.				
S.				
A.				
R.				
PE.				
G.				

Date Comm. MIR

SEP 12 '56

FIRST REPORT

County Pawnee Elev. 2100  
 Sec. 17 Twp. 23 Rge. 17W  
 Company Hilton Drlg.  
 FarmName Hutchinson "A" No. 9

TOPS	DEPTH	LOG	DATUM	Loc. in Sec.
Anh.	<u>1125</u>			<u>C W 1/2 SW NE</u>
Hp.				
H.	<u>3678</u>			<u>600' SL</u>
Tr.				<u>330' WL</u>
Dg.	<u>3775</u>	<u>3777</u>		
Bl.	<u>3794</u>	<u>3796</u>		
L.				
K.C.				Geol. _____
B.K.C.				Contr. _____
Ce.				<u>Co. tools</u>
C.	<u>5414</u>	<u>4319</u>		Pool <u>Garfield</u>
M.		<u>4246</u>		
M.		<u>4310</u>		
K.				
Mz.				
Ma.				
V.				
S.				
S.				
A.				
R.				
PE.				
G.				

Date Comm. MIR

OCT 10 1956

SEP 19 '56 9-12-56

8' 1/8 324 / 200 1/2 3215 SEP 26 '56

OCT 3 '56 4377 DST 4235-50

1 1/2 20' 56 CM FP 25-25 BHP

128 DST 4250-60 1 1/2

see 70' 50 8' 6 CM BHP 140 DST

4270-90 1 1/2 see 70' HO 8' 6 CM BHP 130 5 1/2 @ 4355

MICF OCT 10 '56 24/4311-15 1/2 Frac

Lost Load PB 4270 48/4254-60

FRAC Lost Ld.

D&A