

KANSAS

Form 51-5M-7-40-Palace


Harvey

Section 17 Township 23 Range 3-W

Well No. #2 Fredrick

Company Valley Osage

NORTH Burrton Pool

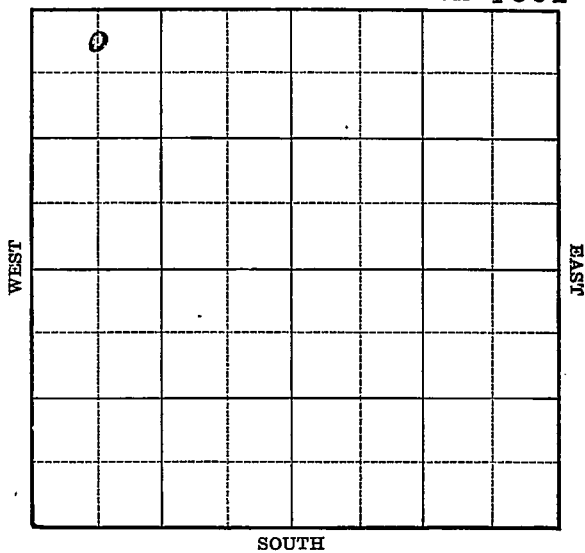

Sec. 17 Twp. 23 R. 3-W

Well No. #2 Fredrick Farm

Valley Osage

Company

(Burrtou)


330 Ft. from N. Line

Ft. from S. Line

Ft. from E. Line

660 Ft. from W. Line

Elev. 1472

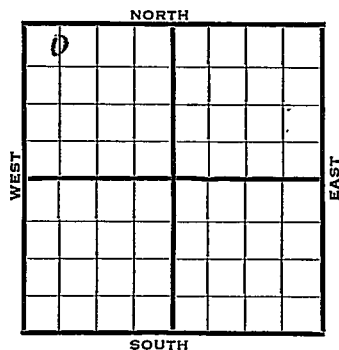

1941	REPORT
1/22	10" - 296'
	Drlg. 730'
1/30	Drlg. 2665'
2/6	Chat. 3272' S/Gas 3334' T.D. 5" - 3334' WOC.
2/13	T.D. 3380' 500' fluid.
2/20	P.B. to 3333'
2/27	P.B. to 3325'
	31 shots 3276-3319' Show gas.
3/6	" " "
3/13	" " "
3/19	Chat. 3272'
	6" - 3334'
	T.D. 3398'
	Water.
	ABANDONED

Map No. 39 Sec. 17 Twp. 23 R. 3WWell No. 2 Fredrick

Valley Osage

Company

Contractor

FIRST REPORT

C N L NW NW

330 Ft. from N. Line Ft. from S. Line Ft. from E. Line660 Ft. from W. Line

BURRTON POOL

SECTION PLAT

0			

Location Rig up

Drilling and Remarks:

10" - 296

Drlg. 730

RECORD

Cased in., ft.Sand Gas Oil Total Depth

PRODUCTION

1st 24 hrs. Nat. 1st 24 hrs. after shot Gas Cu. Ft.Dry Hole Abandoned

Date

JAN 22 1941

19

S. J. LEWIS

Scout

Map No. 39 Sec. 17 Twp. 23 R. 3WWell No. 2 FredrickValley Osage CompanyABANDONED Contractor

SECTION PLAT

C N L NW NW

330 Ft. from N. Line Ft. from S. Line Ft. from E. Line660 Ft. from W. Line

BURTON POOL

0			

Location Rig up

Drilling and Remarks:


RECORD

Cased in., ft.Sand Gas Oil Total Depth 3398.

PRODUCTION

1st 24 hrs. Nat. 1st 24 hrs. after shot Gas Cu. Ft.Dry Hole Abandoned

Date

MAR 19 1941 19 S. J. LEWIS Scout