



Sec. 17 Twp. 23 R. 3 W

Well No. # 5 Frederick Farm

Gilcrease Oil Company

Contractor


990 Ft. from N. Line

_____ Ft. from S. Line

330 Ft. from E. Line

_____ Ft. from W. Line

SE NE NW

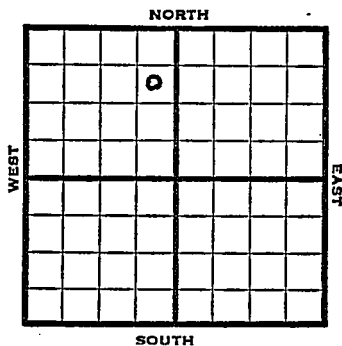

1952

Elev. 1467' REPORT

8/6 Spud 8-3-52
8" @ 310'

8/13 Drlg. 2820'

8/20 Br Li 2516 Lans. 2542
BKC 2980 Cherokee sh 3148
Miss 3253 RTD 3343
5" @ 3343 DD 3351 Fill up 200'
oil & some wtr 8 hrs. DD 3356

8/27 NR

9/3 "

9/10 "

9/17 Spud 8-3-52
Oil well TD 3370' 8" @ 310
Br. lime 2516' Lans. 2542' B KC 2980
Cherokee sh. 3148' Miss. 3253'
TD 3343' 5" @ 3343 DD 3351'
FU 200' oil DD 3356 DD 3370
2000 A
Comp. 50 BOPD

COMPLETED

County Harvey State Kansas

Sec. 17 (Blk. 23) (Sur. 3W) Map No.

Operator Gilcrease Oil

Well No. 5 Farm Frederick

Elev. Location SE NE NW

EXPLORATION REPORT

990 Ft. From N Line NW

330 Ft. From E Line Quarter

1st. Report AUG 6 1952

Completion _____

Remarks _____

Spudding Date 8-3-52

Drilg. Data _____

8" @ 310

J. G. McGEHEE

County Harvey State Kansas

Sec. 17 (Blk. Twp.) 23 (Sur. Rge.) 3W Map No.

Operator Gilcrease Oil

Well No. 5 Farm Frederick

Elev. 1467 Location SE NE NW

		0			

990 Ft. From N Line NW

330 Ft. From E Line Quarter

1st. Report

Completion SEP 17 1952

Remarks

Spudding Date 8-3-52

Drlg. Data Oil well TD 3370

8" @ 310 Br. lime 2516 Lens. 2542

B KC 2980 Cherokee sh. 3148

Miss. 3253 TD 3343 5" @ 3343 DD 3351

FU 200' oil DD 3356 DD 3370 2000 A

Comp. 50 bopd