

KANSAS Harvey

Section 17 Township 23 Range 3WWell No. #3 HowellCompany Lebow & Sohio

Burrtton Pool

NORTH

WEST

		0					

EAST

SOUTH

6

KANSAS

Harvey

Sec. 17 Twp. 23 R. 3W ✓

Well No. #3 Howell Farm

Lebow & Sohio Company

Burrton Pool


 Ft. from N. Line

990' Ft. from S. Line

990' Ft. from E. Line

 Ft. from W. Line

NW SE NW

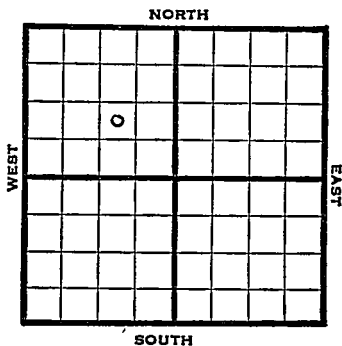

1948 Elev. 1466' REPORT

2/11 RUR
2/18 10" @ 325'
Drlg 500'
2/25 Drlg. 25' 70'
3/3 Mississippi 3264'
TD 3345'
5" @ 3339'
RUST
3/10 TD 3347'
500 Acid
3/17 TD 3363'
3/24 Miss. 3264'
5" @ 3339'
1000 Acid
Pump 50 oil & 15W Pot.
Gr. 37°
TD 3363'

COMPLETED

Map No. _____ Sec. 17 Twp. 23 R. 3W

Well No. 3 Howell

Lebow & Sohio Company

FIRST REPORT Contractor

NW SE NW

SECTION PLAT

	o		.

_____ Ft. from N. Line

990 Ft. from S. Line

990 Ft. from E. Line

_____ Ft. from W. Line

Harvey County

Location _____

Rig up _____

Drilling and Remarks:

R U R

RECORD

Cased _____ in., _____ ft.

Sand _____

Gas _____

Oil _____

Total Depth _____

PRODUCTION

1st 24 hrs. Nat. _____

1st 24 hrs. after shot _____

Gas _____ Cu. Ft.

Dry Hole _____

Abandoned _____

Date

FEB 11 1948 19

S. J. LEWIS Scout

Map No. 39 Sec. 17 Twp. 23 R. 3W

Well No. 3 Howell

Lebbow & Sohio Company

COMPLETE Contractor

NW SE NW


E1.1466.
SECTION PLAT

 Ft. from N. Line

990 Ft. from S. Line

990 Ft. from E. Line

 Ft. from W. Line

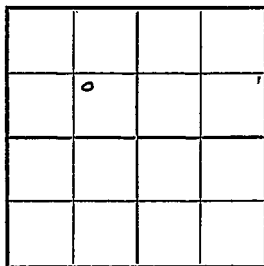

Harvey County

Location

Rig up

Drilling and Remarks:

Miss 3264

5' 03339

1000 ac

Prod 50 oil + 15 W

Box

37° SW

RECORD

Cased in., ft.

Sand

Gas

Oil

Total Depth 2863

PRODUCTION

1st 24 hrs. Nat.

1st 24 hrs. after shot

Gas Cu. Ft.

Dry Hole

Abandoned

Date

MAR 24 1948 19

S. J. LEWIS Scout