

KANSAS

Form 51—5M—7-39—Palace,

Harvey

Section 17 Township 23 Range 3-W

Well No. #1 Saylor

Company E. J. Shaffer

NORTH Burrton Pool

0							

WEST EAST

SOUTH

13

KANSAS


Harvey

Sec. 17 Twp. 23 R. 3-WWell No. #1 Saylor FarmE. J. Shaffer Company

(Burrton)

 Ft. from N. Line660 Ft. from S. Line Ft. from E. Line330 Ft. from W. Line

Elev. 1459

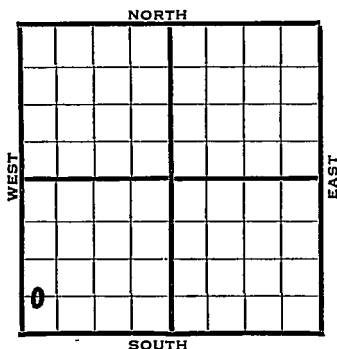

1940	REPORT
6/19	10" - 280' WOC.
6/27	K.C. 2717' Drlg. 2850'
7/3	T.D. 3307' 7" - 3303' RUST.
7/11	Miss. 3255' T.D. 3337' RUST.
7/18	T.D. 3366' H.F.O.
7/25	1000 acid. Swab 100 bbls. 4 hrs.
8/2	" " " " "
8/7	Miss. 3255'
	7" - 3303'
	T.D. 3366'
	2000 acid.
	Potential 590 bbls., pump.

COMPLETED

Map No. 39 Sec. 17 Twp. 23 R. 3WWell No. 1 SaylorE. J. Shaffer

Company

Contractor

FIRST REPORT

C W L SW SW

 Ft. from N. Line660 Ft. from S. Line Ft. from E. Line330 Ft. from W. Line

SECTION PLAT

0			

BURRTON POOL

Location Rig up

Drilling and Remarks:

10" - 280WOC

RECORD

Cased in., ft.Sand Gas Oil Total Depth

PRODUCTION

1st 24 hrs. Nat. 1st 24 hrs. after shot Gas Cu. Ft.Dry Hole Abandoned

Date

JUN 19 194019S. J. LEWIS Scout

Map No. 39 Sec. 17 Twp. 23 R. 3WWell No. 1 SaylorE. J. Shaffer

Company

Contractor

COMPLETED
C W L SW SW**SECTION PLAT**

0			

 Ft. from N. Line660 Ft. from S. Line Ft. from E. Line330 Ft. from W. Line**BURRTON POOL**Location Rig up

Drilling and Remarks:

*Miss 3255-**7" @ 3803**2000 acid**Pump. 590 Bx.***RECORD**Cased in., ft.Sand Gas Oil Total Depth 2866**PRODUCTION**1st 24 hrs. Nat. 1st 24 hrs. after shot Gas Cu. Ft.Dry Hole Abandoned

Date

AUG 7 1940 19S. J. LEWIS Scout