


Section 17 Township 23 Range 3W

Well No. #2 Seiman

Company Don Ingling

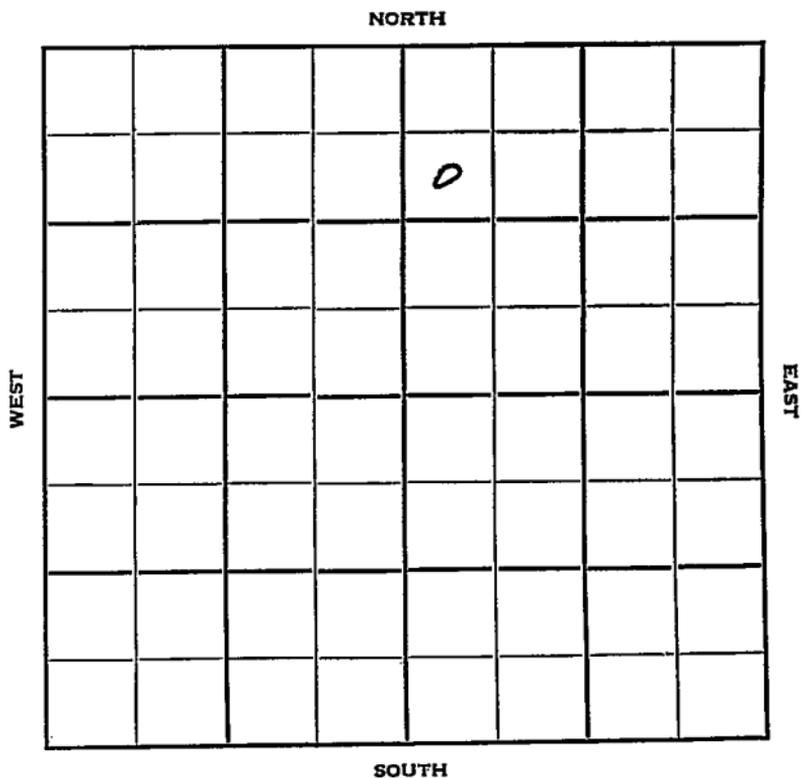

Sec. 17 Twp. 23 R. 3W

Well No. #2 Seiman Farm

Don Ingling Company


 Contractor

990 Ft. from N. Line

_____ Ft. from S. Line

_____ Ft. from E. Line

330 Ft. from W. Line

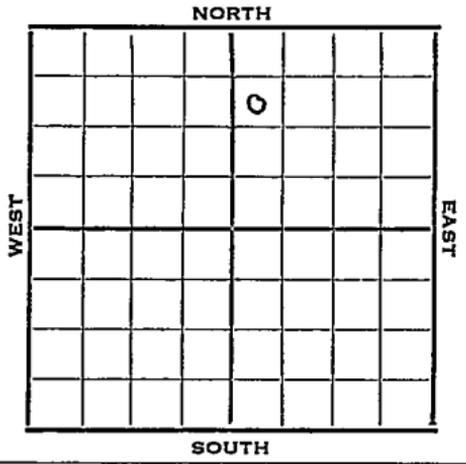

SW NW NE

1952 Elev. 1467' REPORT

- 8/27 Spud 8-21-52
8" @ 300'
Drlg. 1403'
- 9/3 Lans. 2539
Drlg. 2820
- 9/10 KC 2836 Miss 3257
SO 3349-54 RTD 3354
5" @ 3349
- 9/17 DD 3367' 1000 A
- 9/24 NR
- 10/1 25 Bopd & 20% wtr.
- 10/8 Spud 8-21-52
Oil well TD 3367' 8" @ 300 Lans
2539' KC 2836' Miss 3257'
SO 3349-54 TD 3354 5" @ 3349
DD 3367 1000 A
Comp. 25 BOPD 20% wtr.

COMPLETED

