

# KANSAS


Harvey

FORM 51 5M 1-42 PETROL

Section 17 Township 23 Range 3-W

Well No. #1 Harvey

Company J. J. Lynn

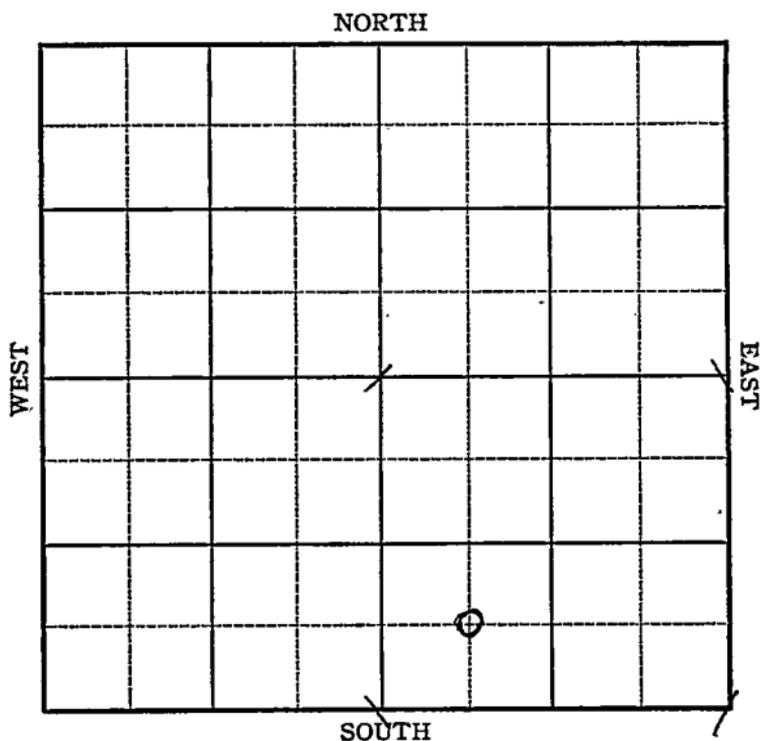


Sec. 17 Twp. 23 R. 3-W

Well No. #1 Havelly Farm

J. J. Lynn Company

\_\_\_\_\_ Ft. from N. Line  
660 Ft. from S. Line  
 \_\_\_\_\_ Ft. from E. Line  
660 Ft. from W. Line

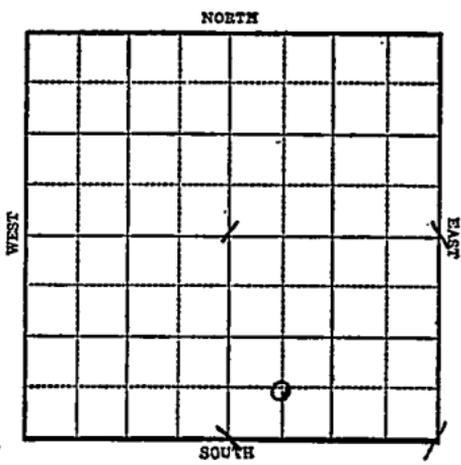

*Elev. 1457*

1943

R E P O R T

5/5	10" @ 284' Drlg. 2345'
5/12	Lans 2530 BKC 2931 Miss 3256 T.D. 3359 So 5" @ 3265 Rust.
5/19	" " "
5/26	T.D. 3359-3M gas flow 5 bbls oil per hr.
6/2	" " " " " "
6/9	5" @ 3271 T.D. 3364 Flow 100 oil in 24 hrs.
6/16	" " " " " "
6/23	Miss 3256 5" @ 3271' T.D. 3364' 1000 acid Flow 100 Pot. Gravity 39

**COMPLETED**

Harvey

KANSAS


Map No. 39 Sec. 17 Twp. 23 R. 3WWell No. 1 HavelyJ. J. Lynn Company

FIRST REPORT

Contractor

C SW SE

## SECTION PLAT

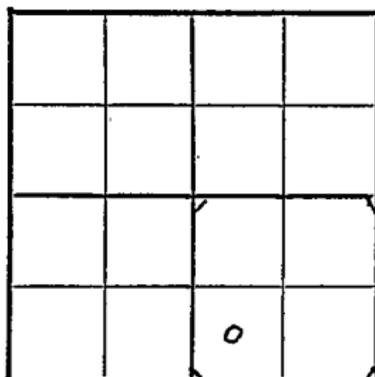         Ft. from N. Line660 Ft. from S. Line         Ft. from E. Line660 Ft. from W. Line

BURTON POOL

Location                                 Rig up                                 

Drilling and Remarks:

10" -284'

Drlg. 2345'

## RECORD

Cased          in.,          ft.Sand                                 Gas                                 Oil                                 Total Depth                         

## PRODUCTION

1st 24 hrs. Nat.                         1st 24 hrs. after shot                         Gas                          Cu. Ft.Dry Hole                                 Abandoned                                 

Date

MAY 5 1943 19

S. J. LEWIS Scout

KANSAS

Harvey

Map No. 39 Sec. 17 Twp. 23 R. 3WWell No. 1 HavelyJ. J. Lynn

Company

**COMPLETED**

Contractor

C SW SE

SECTION PLAT

         Ft. from N. Line660 Ft. from S. Line         Ft. from E. Line660 Ft. from W. Line


**BURTON POOL**Location         Rig up         

Drilling and Remarks:

*Misc 3256*  
*5' @ 3274'*  
*1000 @ 3256*  
*Fluid 100 PZ*

*39° SW*

RECORD

Cased          in.,          ft.Sand         Gas         Oil         Total Depth 3364

PRODUCTION

1st 24 hrs. Nat.         1st 24 hrs. after shot         Gas          Cu. Ft.Dry Hole         Abandoned         

Date

JUN 23 1943

19

S. J. LEWIS Scout