

KANSAS


Form 51-5M-7-39-Palace

Harvey

Section 17 Township 23 Range 3-W

Well No. #1 Howell

Company Hipple Oil

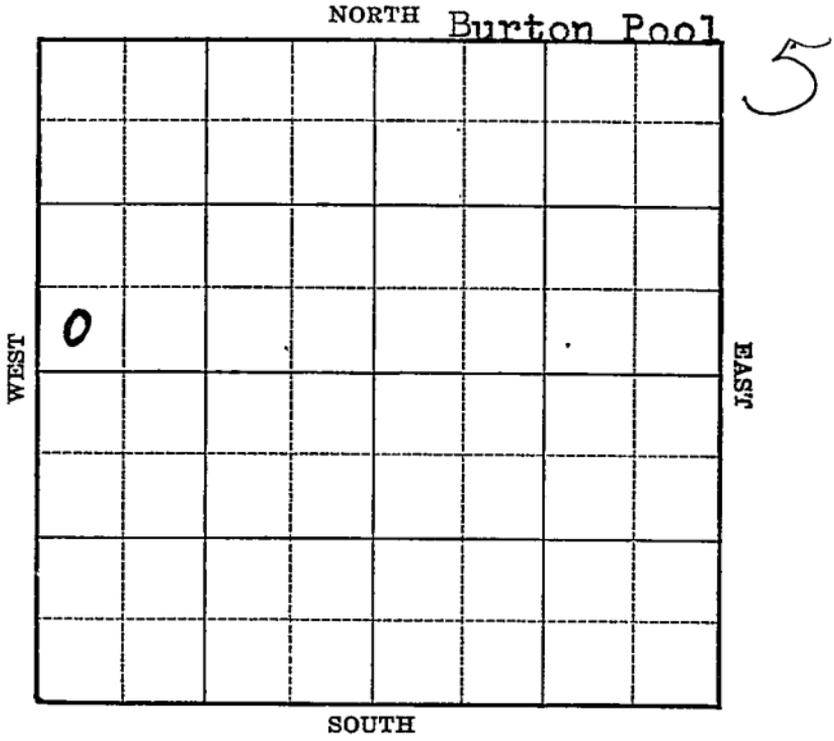

Map No. 39 Sec. 17 Twp. 23 R. 3W

Well No. 1 Howell

Hipple Oil

Company

Contractor

FIRST REPORT

SW NW

SECTION PLAT

_____ Ft. from N. Line

330 Ft. from S. Line

_____ Ft. from E. Line

330 Ft. from W. Line

BURTON POOL

Location _____

RECORD

Rig up _____

Drilling and Remarks:

Matl. Rotary

Cased _____ in., _____ ft.

Sand _____

Gas _____

Oil _____

Total Depth _____

PRODUCTION

1st 24 hrs. Nat. _____

1st 24 hrs. after shot _____

Gas _____ Cu. Ft.

Dry Hole _____

Abandoned _____

Date

SEP 27 1939

19

S. J. LEWIS

Scout

Map No. 39 Sec. 17 Twp. 23 R. 3WWell No. 1 HowellHipple Oil

Company

Contractor

COMPLETED**SECTION PLAT**

SW NW

_____ Ft. from N. Line

330 Ft. from S. Line

_____ Ft. from E. Line

330 Ft. from W. Line

BURRTON POOL

Location _____

Rig up _____

Drilling and Remarks: :

*Chas 3249**7" @ 3306 1/2**4000 acid**Flow 782 P.S.***RECORD**

Cased _____ in., _____ ft.

Sand _____

Gas _____

Oil _____

Total Depth 3370**PRODUCTION**

1st 24 hrs. Nat. _____

1st 24 hrs. after shot _____

Gas _____ Cu. Ft.

Dry Hole _____

Abandoned _____

Date

NOV 15 1939 19

S. J. LEWIS Scout