

Section 17 Township 23 Range 12WWell No. #1 RingCompany Walters Drlg.

NORTH							
				0			
SOUTH							

WEST

EAST

Stafford

KANSAS ✓

Sec. 17 Twp. 23 R. 12W

Well No. #1 Ring Farm

Walters Drlg. Company

Walters Drlg. Contractor

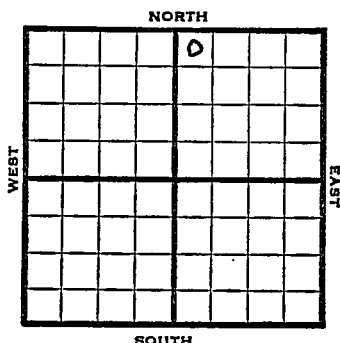
Wildcat

330 Ft. from N. Line

 Ft. from S. Line

 Ft. from E. Line

330 Ft. from W. Line



NW NW NE

Stano. & Phillips DHM

1953 Elev. 1865'

REPORT

4/29

Spud 4-22-53

8" @ 215

Drlg. 2660'

5/6

Spud 4-22-53

D&A

TD 3891

8" @ 215

Heeb 3234, Tor 3253, Br line 3374,

Lans 3399

DST 3570-93, opn 1 hr., rec. 30' sw,
870#

Cong 3670, Viola 3720

DST 3722-79, opn 3/4 hrs., rec. 15'

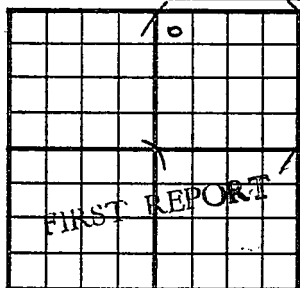
mud, 0#

Simp 3797, Arb. 3851

TD 3891

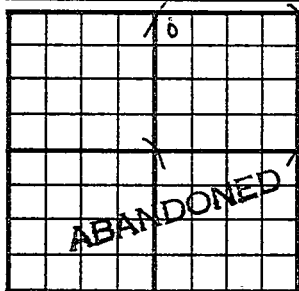
D&A

ABANDONED

County Stafford State KansasSec. 17 (Blk. Twp.) 23 (Sur. Rge.) 12th Map No.Operator Walters Drlg.Well No. 1 Farm RingElev. _____ Location NE 1/4 Sec 23 Twp 17 N Rge 12 E330 Ft. From N Line NE330 Ft. From W Line Quarter1st. Report APR 29 1953

Completion _____

Remarks Stano. & Phillips DEMWalters Drlg. - Contr.Spudding Date 4-22-53Drlg. Data Wildcat8" @ 215 drlg. 2660

County Stafford State KansasSec. 17 (Blk. 23 (Sur. 12W Map No.
Twp.) Rge.)Operator Walters Drlg.Well No. 1 Farm RingElev. 1865 Location NW NW NE330 Ft. From N Line NE330 Ft. From W Line Quarter1st. Report Completion MAY 6 1953Remarks WildcatWalters Drlg. - Contr.Spudding Date 4-22-53Drlg. Data D & A TD 389H8" @ 215 Heeb. 3234 Tor. 3253Br. lime 3374 Lans. 3399 DST 3570-93open 1 hr. Rec. 30' sw 870#Cong. 3670 Viola 3720 DST 3722-79open 3/4 hr. Rec. 15' mud 0#Simp. 3797 Arb. 3851 TD 389HD & A