

Pawnee

KANSAS

SECTION 17 TOWNSHIP 23 RANGE 15 W

WELL NO. #1 Esmiller

COMPANY Elreco et al

NORTH

	0						

WEST

EAST

SOUTH

75 W

FARM

Eléco et al

Lewis Drlg.

Wildcat


Ft. from N. Line

Ft. from S. Line

Ft. from E. Line

Ft. from W. Line

NE NW NW

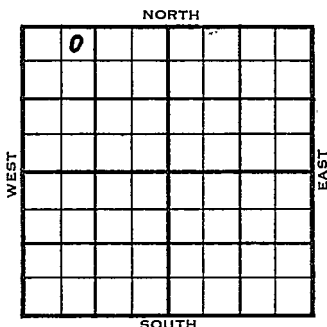

SDX - 1/2 Mile

ELEVATION

1955

2025

REPORT

10/26 Comm. 10-22-55
8" @ 320/175
Drlg. 1170'

11-4	Anhy, 980,	Heeb. 3501
	Tor. 3523,	Doug. 3540
	Br. lime 3628	Land. 3638
	BKC 3884'	Cong. 3986
	Drlg. 4005'	

11/9	Comm 10-22-55
	8 th @ 320/175
Anh	980
H	3501
Tr	3523
Dg	3540
BL	3628
L	3638
BKC	3884
C	3986
V	4004
S	4032
A	4126
TD	4132
D & A	

ABANDONED

County Pawnee Elev. _____
 Sec. 17 Twp. (23) Rge. 35W
 Company Fireco et al.
 Farm Name Esmliler No. 1

TOPS	DEPTH	LOG	DATUM	Loc. in Sec. _____
Anh.				NE NW NW
TP.				
H.				
Tr.				
Dg.				
Bl.				
L.				Geol. _____
K.C.				Contr. _____
B.K.C.				Lewis Drlg.
Ce.				
C.				Pool
M.				Wildcat
M.				
K.				
Mz.				
Me.				
V.				
S.				
S.				
A.				
R.				
Pe.				
G.				
T.D.				

0	1	2
1/2 mile		
FIRST REPORT		
OCT 26 '55		

Date Comm. 10-22-55
8" @ 320/175 d rlg. 1170

Co.

Lse.

No.

Sec.

T.

R.

County Pawnee Elev. 2025
 Sec. 17 Twp. 23 Rge. 15W
 Company Elreco et al.
 Farm Name Esmiller No. 1

TOPS	DEPTH	LOG	DATUM	Loc. in Sec.
Anh.	980			NE NW NW
TP.				
H.	3501		1476	
Tr.	3523		1498	
Dg.	3540		1515	
Bl.	3628		1603	
L.	3638		1613	
K.C.				Geol.
B.K.C.	3884		1859	Contr.
Ce.				Lewis Drlg
C.	3986		1961	
M.				Pool
M.				Wildcat
K.				
Mz.				
Mq.				
V.	4004		1979	
S.	4032		2067	
S.				
A.	4126		2101	
R.				
PE.				
G.				
T.D.	4132			

Date Comm. 10-22-55 NOV 9 1955

8" @ 320/175

D & A

ABANDONED