

KANSAS

Pawnee

Section 17 Township 23 Range 17W

Well No. 1 Hutchinson


Company NCR A
~~Gabert & Linds~~

Wildcat

NORTH

WEST

EAST

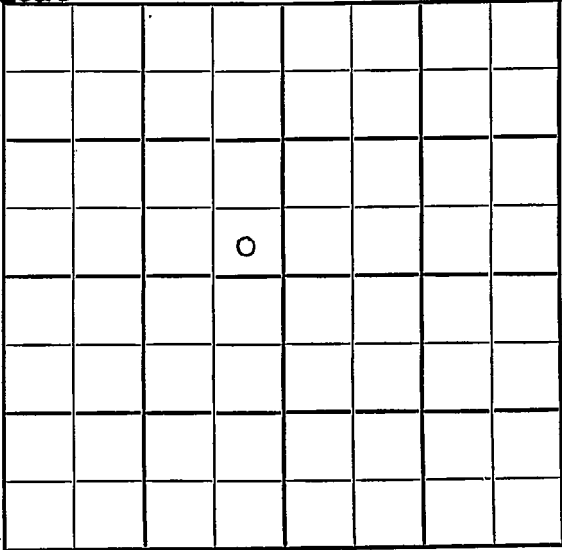

SOUTH

6

KANSAS Pawnee



Sec. 17 Twp. 23 R. 17W

Well No. #1 Hutchinson Farm

~~Gabert & Lindas~~ N.C. L.A. Company


Wildcat

 Ft. from N. Line

330 Ft. from S. Line

330 Ft. from E. Line

 Ft. from W. Line

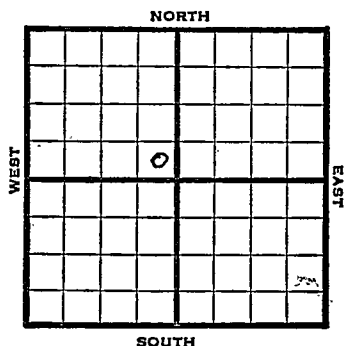

SE NW

1947 Elev. 2107' REPORT

10/15 10" @ 365'
Drlg. 3250'

10/22 Lansing 3793'
Drlg. 3959'

10/26 BKC 4143'
Mississippi 4238'
Viola 4323'
Drlg. 4410'

11/5 Simpson Sd 4563' Misener 4288'
Arbuckle 4600
TD 4655'
5" @ 4356'
RUST

11/12 "

11/19 6 shots 4314-17 Water
6 " 4312-14 6 bailers oil &
2 bbls W PH

11/25 12 shots. 4296-4300'
Swb. 65 bbls. oil $\frac{1}{2}$ M Gas.

12/3 "

12/10 "

12/17 "

12/30 "

1948
1/7 "

OVER

1948

1/14 12 shots 4296-4300' :
Swb 65 bbls oil $\frac{1}{2}$ W Gas

1/21 SD

1/26 "

2/4 "

2/11 "

2/18 "

2/25 "

3/3 "

3/10 "

3/17 "

3/24 Misener 4288'

Arb 4605'

5" @ 4356'

Perf. Misener

Pump 15 Pot.

Gr. 27°

TD 4655'

COMPLETED


Kansas

Map No. _____ Sec. 17 Twp. 23 R. 17WWell No. 1 Hutchinson

_____ Gabert & Lindas _____ Company

FIRST REPORT _____ Contractor

SE NW

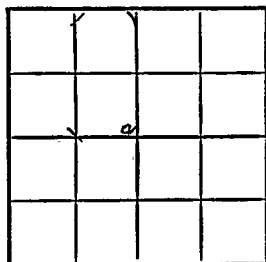SECTION PLAT

_____ Ft. from N. Line

330 Ft. from S. Line330 Ft. from E. Line

_____ Ft. from W. Line

Pawnee County

Location _____

Rig up _____

Drilling and Remarks:

10" @ 365

drlg. 3250

RECORD

Cased _____ in., _____ ft.

Sand _____

Gas _____

Oil _____

Total Depth _____

PRODUCTION

1st 24 hrs. Nat. _____

1st 24 hrs. after shot _____

Gas _____ Cu. Ft.

Dry Hole _____

Abandoned _____

Date

OCT 15 1947 19S. J. LEWIS Scout

Map No. 84 Sec. 17 Twp. 23 R. 17W

Well No. 1 Hutchinson

N C R A

Company

CORRECTION

Contractor

SE NW


SECTION PLAT

_____ Ft. from N. Line

330 Ft. from S. Line

330 Ft. from E. Line

_____ Ft. from W. Line

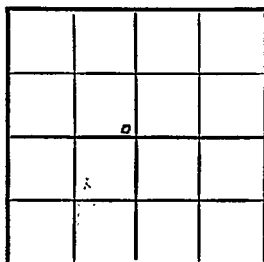

Pawnee County

Location _____

Rig up _____

Drilling and Remarks: _____

Reported

Gabert & Lindas

RECORD

Cased _____ in., _____ ft.

Sand _____

Gas _____

Oil _____

Total Depth _____

PRODUCTION

1st 24 hrs. Nat. _____

1st 24 hrs. after shot _____

Gas _____ Cu. Ft.

Dry Hole _____

Abandoned _____

Date

NOV 1 0 1947 19

S. J. LEWIS

Scout

Map No. 84 Sec. 17 Twp. 23 R. 17W

Well No. 1 Hutchinson

N C R A Company

COMPLETE

Contractor

SE NW

E1,210?
SECTION PLAT

 Ft. from N. Line

330 Ft. from S. Line

330 Ft. from E. Line

 Ft. from W. Line

	5		

Pawnee County

Location

Rig up

Drilling and Remarks:

Mud in 4255
Cu 4605
5' @ 4856.
Perf. 11' @ 4856
Pump 15' @ 4856
27° E.

RECORD

Cased in., ft.

Sand

Gas

Oil ✓

Total Depth 4650

PRODUCTION

1st 24 hrs. Nat.

1st 24 hrs. after shot

Gas Cu. Ft.

Dry Hole

Abandoned

Date

MAR 24 1948

19

S. J. LEWIS

Scout