

Pawnee

KANSAS

17

23


17W

SECTION _____ TOWNSHIP _____ RANGE _____

WELL NO. #9 Hutchinson "A"

COMPANY Hilton Drlg.

NORTH

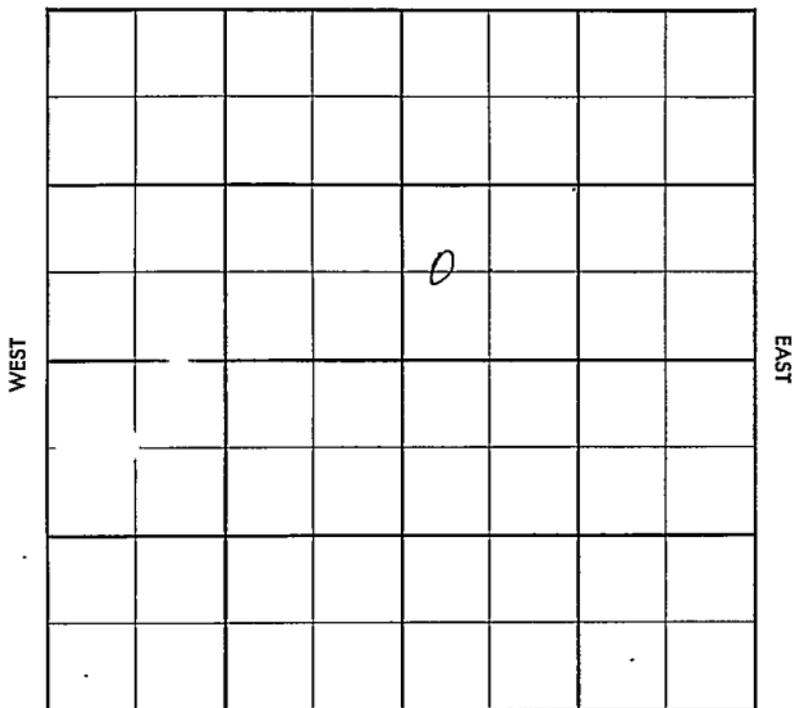

SOUTH


SEC.	TWP.	R.
17	23	17W

WELL NO. #9 Hutchinson "A" FARM

COMPANY Hilton Drlg

CONTRACTOR Co Tools

_____ FT. FROM N. LINE
 600 _____ FT. FROM S. LINE
 _____ FT. FROM E. LINE
 330 _____ FT. FROM W. LINE

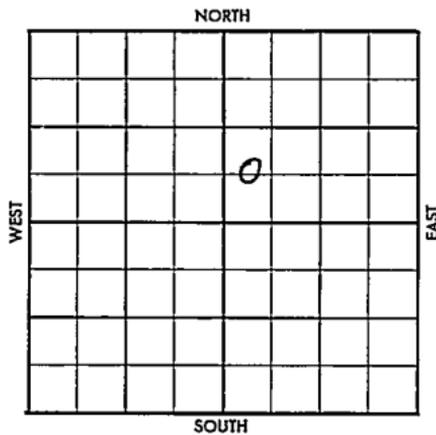

C W/1/2 SW NE

ELEVATION	REPORT
1956	

9-12	MIR
------	-----


County Pawnee Elev. _____
 Sec. 17 Twp. 23 Rgs. 17W
 Company Hilton Drlg.
 Farm Name Hutchinson "A" No. 9

TOPS	DEPTH	LOG	DATUM
Anh.			
Tp.			
H.			
Tr.			
Dg.			
Bl.			
L.			
K.C.			
B.K.C.			
Ce.			
C.			
M.			
M.			
K.			
Mz.			
Me.			
V.			
S.			
S.			
A.			
R.			
PE.			
G.			
T.D.			

Loc. in Sec. C W¹/₂ SW NE
600' SL
330' WL
 Geol. _____
 Contr. _____
Co. tools
~~Pool Godfield~~

SEP 12 '56
0
FIRST REPORT

Date Comm. M I R

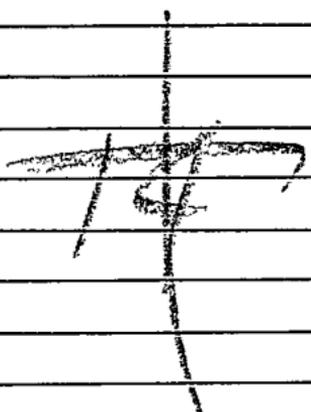

Co.
 Sec.
 T.
 R.

[Faint, illegible handwritten notes or signatures]

County Pawnee Elev. 2100
 Sec. 17 Twp. 23 Rge. 7W
 Company Hilton Drle.
 Farm Name Hutchinson "A" No. 9

TOPS	DEPTH	LOG	DATUM	Loc. in Sec.
Anh.	1125			C W ¹ / ₂ SW NE
TP.				
H.	3678			600' SL
Tr.				330' WL
Dg.				
Bl.	3775 3777			
L.	3794 3796			
K.C.				Geol.
B.K.C.				Contr.
Ce.				Co. tools
C.	5414	4219		
M.				
M.		4246		
K.				
Mz.		4310		
Mo.				
V.				
S.				
S.				
A.				
R.				
PE.				
G.				
TD.		4366		



Date Comm. OCT 10 1956
M I R SEP 19 '56 9-12-56
8 1/8 324 / 200 @ 3215 SEP 26 '56 ✓
OCT 3 '56 @ 4377 DST 4235-50
1 hr 20' 56 GCM FP 25-25 BHP
128 DST 4250-60 of 1 hr
see 70' 50' 6 GCM BHP 140 DST
4270-90 1 1/2 hr see 70' HOE
GCM BHP 130 5 1/2 @ 4355
M I R OCT 10 '56 24 / 4311-15 No Frag
Lost Load PB 4270 48 / 4254-60

Frac Lost Ld.

D&A

17-23-17 c w/2 sw ne