


DX 78-1

Section 17 Township 23 Range 17W

Well No. 5 Hutchinson "B"

Hilton Drlg.

Company _____

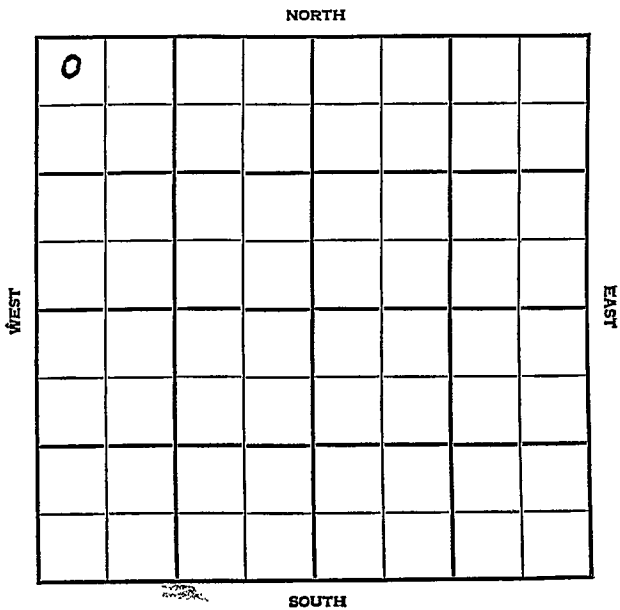

Pawnee KANSAS

SEC.	TWP.	R.
17	23	17W

WELL NO. 5 Hutchinson "B" FARM

COMPANY Hilton Drlg

CONTRACTOR Hilton Drlg.-


Garfield Pool

330 Ft. from N. Line

Ft. from S. Line

Ft. from E. Line

330 Ft. from W. Line

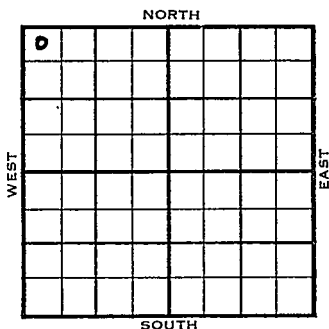

NW NW NW

	ELEVATION	REPORT
1954	2085'	

7/28

M I R

10/27

Spud 7-26-54 Oil well TD 4348
 8" @ 235 Anhy 1117' Heeb 3670
 Doug 3701 Br. lime 3777' KG 3786
 Cong. 4236
 DST 4236-63, open 1 hr rec 16' mud.
 15' mud w/oil spks. 605#
 Miss 4267' Viola 4344 TD 4348
 5" @ 4347' CO to 4339 36/4302-06
 frac. 36/4302-06 Brac. S/8 BOPH
 8 hr. P/10 BO 17 hr. 80% wtr.
 SP 4290 60/4266-76 petro-frac
 S/3.36 BOPH 5 hr. SP 4260 42/4242-49
 S/1 1/2 BOPH 3 hr. Petro-frac. S/15-16
 BOPH Comp. 123 BOPD

COMPLETED

County Pawnee State Kansas

Sec. 17 (Blk. 23 (Sur. Rge. 17W) Map No.

Operator Hilton Drlg.

Well No. 5 Farm Hutchinson "B"

Elev. _____ Location NW NW NW

0					

330 Ft. From N Line NW

330 Ft. From W Line Quarter

JUL 28 1956

Ist. Report _____

Completion _____

Remarks _____

Hilton Drlg. - Contr.

Spudding Date _____

Drlg. Data Garfield Pool

M I R

County Pawnee State Kansas

Sec. 17 (Blk. Twp.) 23 (Sur. Rge.) 17W Map No.

Operator Hilton Drlg.

Well No. 5 Farm Hutchinson "B"

Elev. 2085 Location NW NW NW

Q					

330 Ft. From N Line NW

330 Ft. From W Line Quarter

1st. Report

Completion OCT 27 1954

Remarks Garfield Pool

Hilton Drlg. - Contr.

Spudding Date 7-26-54

Drlg. Data Oil well TD 4348

8" @ 235 Anhy 1117 Heeb. 3670

Doug. 3701 Br. lime 3777 KC 3786

Cong. 4236 DST 4236-63 open 1 hr.

Rec. 16' mud 15' mud w/ oil spks. 605#

Miss. 4267 Viola 4344 TD 4348 5" @ 4347

CO to 4339 36/ 4302-06 frac 36/ 4302-06

frac S/ 8 boph 8 hr. P/ 10 bo 17 hr.

80% wtr. SP 4290 60/ 4266-76 petro-frac

S/ 3.36 boph 5 hr. SP 4260 42/ 4242-49

S/ 1 1/2 boph 3 hr. petrofrac S/ 15-16 boph

Comp. 123 bopd

FABER G. LSTRAP