

Pawnee

KANSAS

SECTION 17 TOWNSHIP 23 RANGE 17 W

WELL NO. #6 Hutchinson "B"

COMPANY Hilton Drlg.

NORTH

	0						

4

WEST

EAST

SOUTH

Pawnee

KANSAS

SEC.	TWP.	R.
17	23	17W

WELL NO. #6 Hutchinson "B" FARM

COMPANY Hilton Drlg.

CONTRACTOR Co. Tools

Garfield


_____ Ft. from N. Line

_____ Ft. from S. Line

_____ Ft. from E. Line

_____ Ft. from W. Line

SE NW N^W

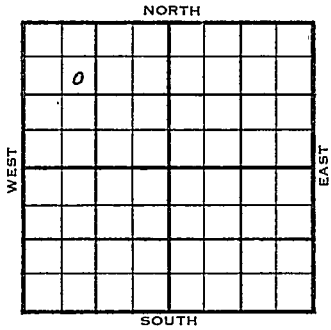

1955 ELEVATION ### 2090 REPORT

11/9 M I R

1956

1-25 Comm. 11-8-55
 8 5/8" @ 221
 DST 4223-43 op 1 hr. rec. 135' vhocm
 320/30"
 DST 4248-68 op 1 hr. rec. 150' socm
 285/20"
 5 1/2" @ 4323
 CO to 4318 80/ 4258-68, 2 gw, SSO
 frac
 S/ 4 bfph 6% wtr.
 Comp. 76 bopd, 4% wtr.
 H. 3670
 BL. 3776
 KC 3784
 C. Shaley 4211
 Cong Ch. 4223
 M. 4238
 Mz. 4249
 V. 4284
 TD 4325

COMPLETED

County Pawnee Elev. _____
 Sec. 17 Twp. 23 Rge. 17W
 Company Hilton Drlg.
 FarmName Hitchinson "B" No. 6

Co.

TOPS	DEPTH	LOG	DATUM
Anh.			
Tp.			
H.			
Tr.			
Dg.			
Bl.			
L.			
K.C.			
B.K.C.			
Ce.			
C.			
M.			
M.			
K.			
Mz.			
Mo.			
V.			
S.			
S.			
A.			
R.			
PE.			
G.			
T.D.			

Loc. in Sec. SE NW NW

Geol. _____

Contr. _____

Co. tools _____

Pool Garfield

NOV 9 '55
 FIRST REPORT

Lse.

T No.

Sec.

T.

R.

Date Comm. M I R

[Handwritten signature]

County Pawnee Elev. 2090
 Sec. 17 Twp. 23 Rge. 17W
 Company Hilton Drlg.
 Farm Name Hutchinson "B" No. 6

TOPS	DEPTH	LOG	DATUM	Loc. in Sec.
Anh.				SE NW NW
Tr.				
H.	3670			Geol.
Tr.				
Dg.				Contr.
Bl.	3776		11686	
L.				Co. tools
K.C.	3784		17694	
B.K.C.				Garfield
Ce.				
C. <u>Shales</u>	4211		2121	COMPLETE
M. <u>Comp. sh.</u>	4223		2133	
M.	4238		2148	
K.				
Mz.	4249		2159	
Ma.				
V.	4284		2194	
S.				
S.				
A.				
R.				
PE.				
G.				
T.D.	4325			

Date Comm. 11-8-55 JAN 25 1956
8 5/8" @ 221 DST 4223-43 open 1 hr.
rec. 135' vhocm 320/30" DST 4248-68
open 1 hr. rec. 150' socm 285/20"
5 1/2" @ 4323 CO to 4318 80/ 4258-68
2 gw SSO frac S/ 4 bfph 6% wtr.
Comp. 76. bopd 4% wtr.