


DX 78-1

Pawnee KANSAS

Section 17 Township 23 Range 17W
Well No. 2 Hutchinson "C"
Company Hilton Drlg.

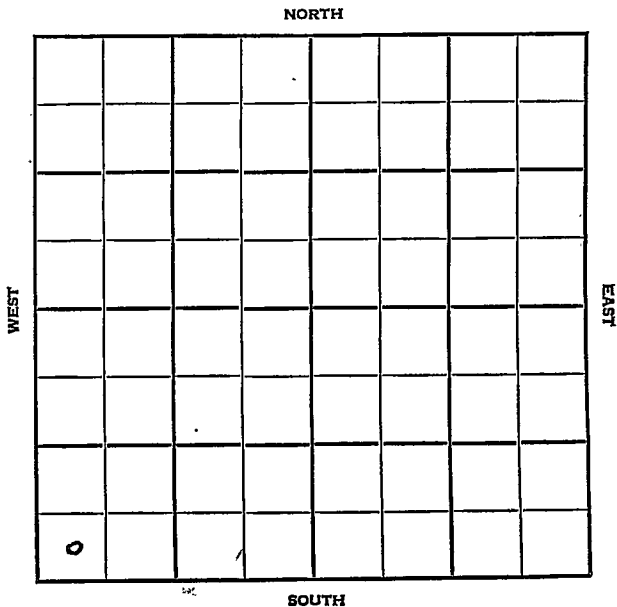

Pawnee KANSAS

SEC.	TWP.	R.
17	23	17 W

WELL NO. # 2 Hutchinson "C" FARM

COMPANY Hilton Drlg.

CONTRACTOR

Garfield Pool


_____ Ft. from N. Line

330 _____ Ft. from S. Line

_____ Ft. from E. Line

330 _____ Ft. from W. Line

SW SW SW

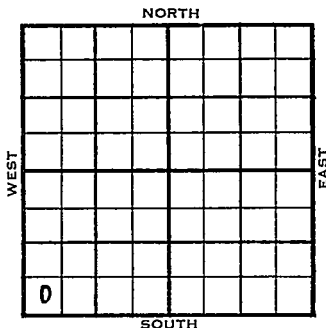

1954

ELEVATION

2099'

REPORT

12/29

Spud 12-26-54
8" @ 224' WOC

1955
2/9

Spud 12-26-54 - Oil Well
TD 4366'
8" @ 224'
Heeb. 3677', Br lime 3787', Lans 3795',
Cong. 4241'
DST 4222-52', opn 1 hr., gas in 3",
F/oil in 37", 1332#
Miss. 4267'
DST 4264-81', opn 1 hr., rec. 6' mud,
25#
DST 4254-81', opn 1 1/2 hrs., gas in 5",
rec. 3440' oil, 1332#
TD 4366'
5" @ 4365'
36/4246-54, sd-oil-frac
1/62 boph 1% wtr.
Misener 4341', Viola 4363'
Comp. 489 bopd

COMPLETED

