

Pawnee

KANSAS

17

23

17W

SECTION _____ TOWNSHIP _____ RANGE _____

#5 Hutchinson "C"

WELL NO. _____


COMPANY Westpan-Hydrocarbon & Hilton Drlg.

NORTH

C NW SW

WEST

EAST

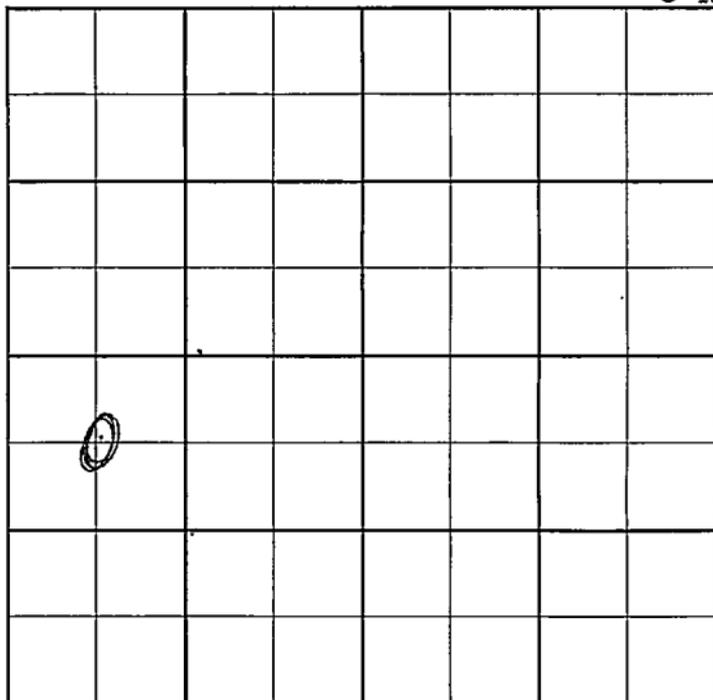

12

SOUTH

County Pawnee Elev. _____
 Sec. 17 Twp. 23 Rge. 17W
 Company Westpan-Hydrocarbon & Hilton Drlg.
 Farm Name Hutchinson "C" No. 5

TOPS	DEPTH	LOG	DATUM	Loc. in Sec.						
Anh.				C NW SW						
Tp.										
H.										
Tr.										
Dg.										
Bl.										
L.				Geol. _____						
K.C.				Contr _____						
B.K.C.				Hilton Drlg.						
Ce.				Pool						
C.				Garfield						
M.				<table border="1"> <tr> <td colspan="2">FIRST REPORT</td> </tr> <tr> <td>o</td> <td></td> </tr> <tr> <td></td> <td>JUN 19 '57</td> </tr> </table>	FIRST REPORT		o			JUN 19 '57
FIRST REPORT										
o										
	JUN 19 '57									
M.										
K.										
Mz.										
Mq.										
V.										
S.										
A.										
R.										
PE.										
G.										
T.D.										

Date Comm. 6-15-57
8" @ 225/200 drlg. 2100

[Handwritten signature]

Co.
 Lse.
 No.
 Sec.
 T.
 R.

County Paynee Elev. 2113
 Sec. 17 Twp. 23 Rge. 17W
 Company Westpan-Hydrocarbon & Hilton Drlg.
 Farm Name Hutchinson "C" No. 5

TOPS	DEPTH	LOG	DATUM	Loc. in Sec.
Anh.	1135			C NW SW
Tr.				
Dg.				
Bl.	3791			
L.				
K.C.	3798			Geol.
B.K.C.				Contr.
C.				Hilton Drlg.
M.	4244			
K.	4248			
Mz.				Garfield N.E.
Ma.				
V.				
S.				
S.				
A.				
R.				
PE.				
G.				
TD.	4290			

COMPLETE
 AUG 7 '57

Date Comm. 6-15-57

8" @ 225/200 drlg. 2100 JUN. 6 7 4221

L 3 57 DST 4244-56 1hr

C/S" ga 1.790 MCF 16" all
 40' @ 3' GCM + 60' Frothy oil
 + 60' Ch. oil BHT 970/30"

DST 4256-76 1hr 15" Md + 550

BHT 50/30" 5 1/2 4288/150

CO ~~4290~~ 4290 FU

200' Fluid/10" FU 600' from

Co.
 Lse.
 No.
 Sec.
 T.
 R.

surf. Blew tools out hole
 § 38 B0 + wtr co 4290
 TP § 3 1/2 BFph 50% wtr
 wtr decreasing § 84 B0
 + wtr in 20 hrs T & R

JUL 10 '57 JUL 17 '57 JUL 24 '57 JUL 31 '57 AUG 7 '57

Ph Pi 53 Bopd no/wtr