

Pawnee


KANSAS

SECTION 17 TOWNSHIP 23 RANGE 17 W

WELL NO. #3 Hutchinson "D"

COMPANY Hilton Drlg.

NORTH

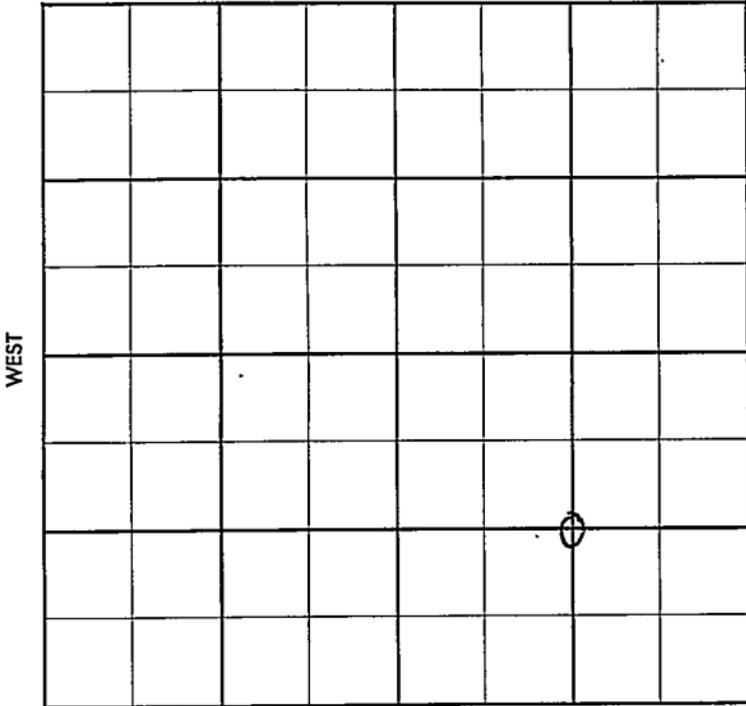

SOUTH

Pawnee

KANSAS

SEC.

17

TWP.

23

R.

17W

WELL NO.

#3 Hutchinson "D"

FARM

COMPANY

Hilton Drlg. & *Sheepskin Hydras-Carbon*

CONTRACTOR

Co. tools


Garfield

\_\_\_\_\_ Ft. from N. Line

\_\_\_\_\_ Ft. from S. Line

\_\_\_\_\_ Ft. from E. Line

\_\_\_\_\_ Ft. from W. Line

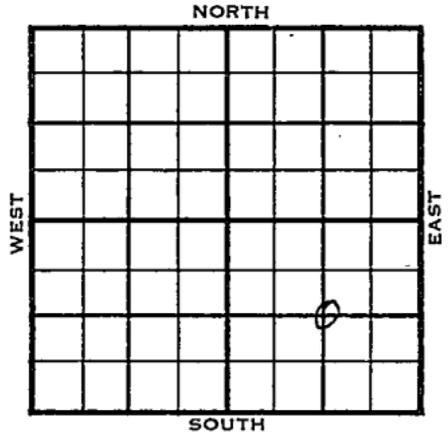

C SE/4

1955	ELEVATION REPORT
12-28	Comm. 12-26-55 8" @ 226/200 WOC

County Pawnee Elev. \_\_\_\_\_  
 Sec. 17 Twp. 23 Rge. 17W  
 Company Hilton Drilg.  
 Farm Name Hutchinson #101 No. 3

TOPS	DEPTH	LOG	DATUM	Loc. in Sec.
Anh.				C SE/4
Sp.				
H.				
Tr.				
Dg.				
Bl.				
L.				Geol. _____
K.C.				Contr. _____
B.K.C.				Co. tools _____
Ce.				Pool _____
C.				Garfield
M.				
M.				
K.				
Mz.				
Mo.				
V.				
S.				
S.				
A.				
R.				
PE.				
G.				
T.D.				

FIRST REPORT  
 DEC 28 '55

Date Comm. 12-26-55  
8" @ 226/200 WOC

*Handwritten signature*

Co.  
 Sec.  
 No.  
 Sec.  
 T.  
 R.

County Parsons Elev. 2106  
 Sec. 17 Twp. 23 Rge. 17W  
 Company Hilton Drig. & Westpan Hydr-carbon  
 Farm Name Hitchinson NDW No. 3

TOPS	DEPTH	LOG	DATUM	Loc. in Sec.
Ab				C SE/4
TP				
H				
Tr				
Sp				
RL	3790		1684	
L				Geol.
RC	3798		1696	Centre
REC				
Co.				Co. tools
C. shale	4226		2120	
M. sh chert	4229		2123	Garfield
M. 155	4263		2157	
K.				
No.				
Mo.				
V.	4253		2247	
S.				
E.				
A.				
R.				
PC				
G.				
TS	4360			

COMPLETE

Date Comp. 12-26-55 FEB 15 1956  
 8" @ 226/200 WOC JAN 5 '56 356.2  
 JAN 11 '56 5 1/2 4358 / JAN 18 '56 WOC T  
 JAN 25 '56 / FEB 1 '56 ~~Bottom 85' - 4260~~  
~~Bottom 85' - 4260~~

~~ST 37/4242-20 Frac #~~  
~~8' Bath 8' Bath #1~~ FEB 8 '58

DST 4246-50 OR 90" rec. 565'  
clean oil... FP 60-145 BHP 1200/20

DST 4263-82 OR 1hr rec. 60' Md  
FP 0-60 BHP 912/30 CO 40/

4250-55 PKR @ 4210 Frac \$

8 1/2' Bath no/w 9' Bath F/W est

4' Bath 7 1/4" ch FP 500#

FTP 100# FEB 15 '58 P. 81 Bath

no/w

R.G.

FEB 27 1958