


Section 17 Township 23 Range 34-W

Well No. 1 Leavitt

Company Champlin Ref.

Hugoton Pool

NORTH

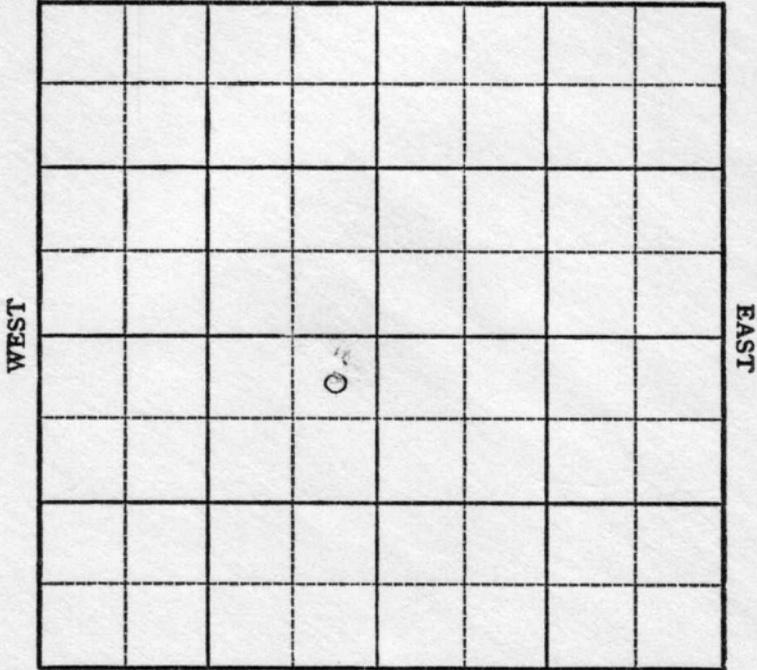

SOUTH

Sec. 17 Twp. 23 R. 34W

Well No. #1 Leavitt Farm

Champlin Ref. Company

Hugoton


330 Ft. from N. Line

_____ Ft. from S. Line

330 Ft. from E. Line

_____ Ft. from W. Line

NE SW

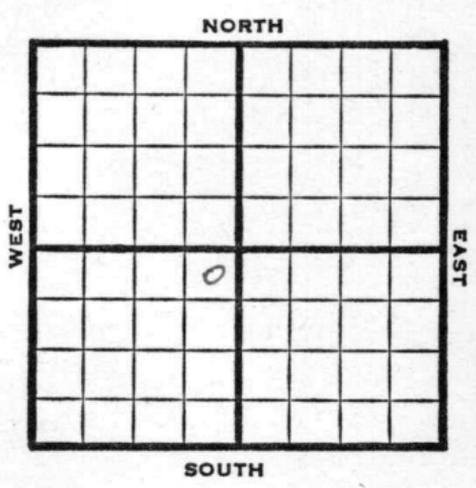

1947

Elev. 2969' **REPORT**

9/17

Location

9/24

10" @ 565'

WOC

10/1

7" @ 2600'

TD 2601'

10/8

"

10/15

"

10/22

TD 2630' 2,000 acid

11/5

7" @ 2585'

Perf.

45,000 Acid

13,000,000 Gas

Total Depth 2630'

COMPLETED

Map No. 0 Sec. 17 Twp. 23 R. 34W

Well No. 1 Leavitt

Champlin Ref. _____ Company

FIRST REPORT

Contractor _____

NE SW


SECTION PLAT

330 Ft. from N. Line

_____ Ft. from S. Line

330 Ft. from E. Line

_____ Ft. from W. Line

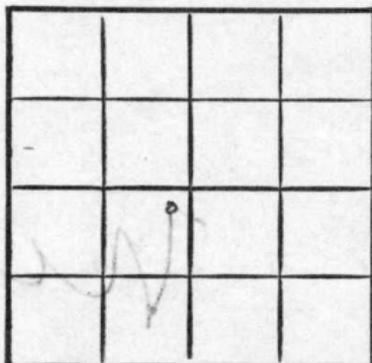

Finney County

Location X

Rig up _____

Drilling and Remarks:

RECORD

Cased _____ in., _____ ft.

Sand _____

Gas _____

Oil _____

Total Depth _____

PRODUCTION

1st 24 hrs. Nat. _____

1st 24 hrs. after shot _____

Gas _____ Cu. Ft.

Dry Hole _____

Abandoned _____

Date

SEP 17 1947 19

S. J. LEWIS Scout

Map No. _____ Sec. 17 Twp. 23 R. 34W

Well No. 1 Leavitt

Champlin Ref. Company

COMPLETE Contractor

NE SW

E 12969
SECTION PLAT

	0		

330 Ft. from N. Line

_____ Ft. from S. Line

330 Ft. from E. Line

_____ Ft. from W. Line

Finney County

Location _____

Rig up _____

Drilling and Remarks:

*7" casing
Ray.
45000 acid

13M Gas*

RECORD

Cased _____ in., _____ ft.

Sand _____

Gas _____

Oil _____

Total Depth 2680

PRODUCTION

1st 24 hrs. Nat. _____

1st 24 hrs. after shot _____

Gas _____ Cu. Ft.

Dry Hole _____

Abandoned _____

Date

NOV 5 1947 19

S. J. LEWIS Scout