


Section 17 Township 23 Range 37W

Well No. 1 Towner

Company Kansas-Nebraska

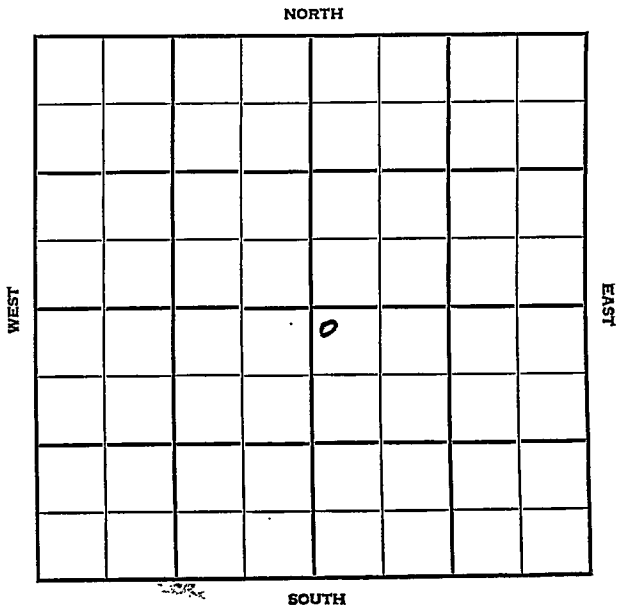

Kearny KANSAS

SEC.	TWP.	R.
17	23	37W

WELL NO. 1 Towner FARM

COMPANY Kansas-Nebraska

CONTRACTOR Honaker


Hugoton Pool

150 Ft. from N. Line

Ft. from S. Line

Ft. from E. Line

150 Ft. from W. Line

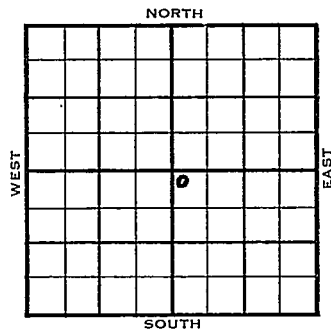

NW NW SE

1955	ELEVATION	REPORT
	3306'	

2/9 Spud 2-4-55
8" @ 340', Drlg.

3/23 Spud 2-4-55, Gas Well, TD 2772
8" @ 340, Her 2620, Kr. 2644,
Win. 2682, Ft. Riley 2746,
TD 2772, 5" @ 2768, 60/2746-56,
1000A, SD 2 days, B/dry, PB
2728, 228/2622-60, 120/2682-
2703, 2,937,000 CFG SI 2 hr.
4,426,000 CFG dolo-flush
Comp. 3,833,000 CFGPD

COMPLETED

County Kearny State Kansas

Sec. 17 (Blk.) 23 (Sur.) 37W Map No.

Operator Kansas-Nebraska

Well No. 1 Farm Towner

Elev. _____ Location NW NW SE

FIRST REPORT					
			0		

150 Ft. From N Line SE

150 Ft. From W Line Quarter

Ist. Report FEB 9 1955

Completion _____

Remarks _____

Honaker - Contr.

Spudding Date 2-4-55

Drlg. Data Hugoton Pool

8" @ 340 drlg.

FABEN GILSTRAP

