

# KANSAS


Harvey

Form 51-5M-7-40-Palace

Section 18 Township 23 Range 3-W

Well No. #1 Horty

Company Hall-Jordan Oil

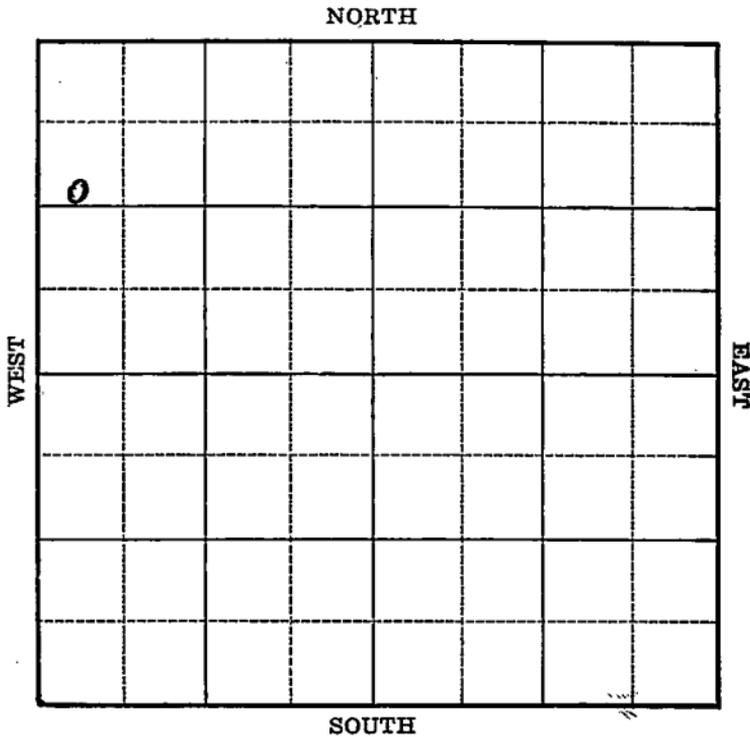

Sec. 18 Twp. 23 R. 3-W

Well No. #1 Horty Farm

Hall-Jordan Oil Company

(Burton)


1265 Ft. from N. Line

\_\_\_\_\_ Ft. from S. Line

\_\_\_\_\_ Ft. from E. Line

330 Ft. from W. Line

Elev. 1472

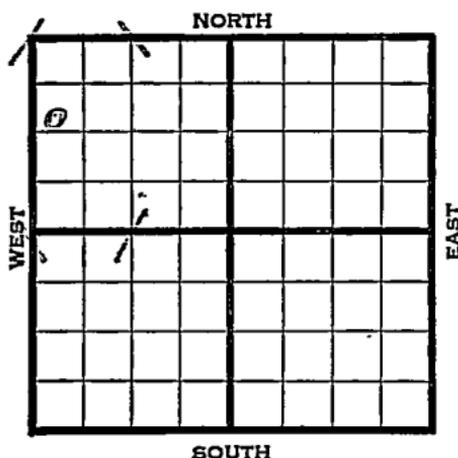

| 1941 | REPORT  |
|------|---|
| 2/12 | 8" - 504' WOC.  |
| 2/20 | Drlg. 2910'   |
| 2/27 | Miss. 3278' 5" - 3317'<br>T.D. 3324' RUST.  |
| 3/6  | T.D. 3361' 2000' oil.   |
| 3/12 | Miss. 3278'<br>5" - 3317'<br>T.D. 3361'<br>2000 acid.<br>Potential 115 bbls., pump.<br>36.6 Gravity |
|      | COMPLETED   |

Map No. 39 Sec. 18 Twp. 23 R. 3WWell No. 1 HortyHall-Jordan Oil CompanyFIRST REPORT Contractor

C W L NW

1265 Ft. from N. Line


\_\_\_\_\_ Ft. from S. Line

\_\_\_\_\_ Ft. from E. Line

330 Ft. from W. Line

BURRTON POOL

## SECTION PLAT

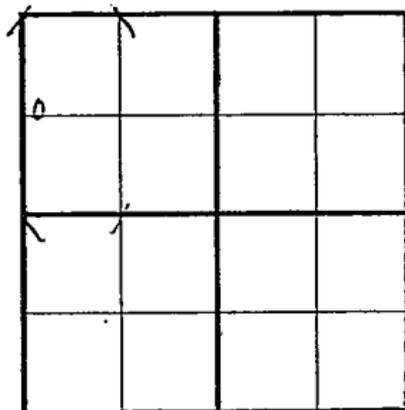

Location \_\_\_\_\_

Rig up \_\_\_\_\_

Drilling and Remarks:

8" - 504 WOC

## RECORD

Cased \_\_\_\_\_ in., \_\_\_\_\_ ft.

Sand \_\_\_\_\_

Gas \_\_\_\_\_

Oil \_\_\_\_\_

Total Depth \_\_\_\_\_

## PRODUCTION

1st 24 hrs. Nat. \_\_\_\_\_

1st 24 hrs. after shot \_\_\_\_\_

Gas \_\_\_\_\_ Cu. Ft.

Dry Hole \_\_\_\_\_

Abandoned \_\_\_\_\_

Date

FEB 12 1941 19

S. J. LEWIS Scout

Map No. 39 Sec. 18 Twp. 23 R. 3WWell No. 1 HortyHall-Jordan Oil Company

Contractor

**COMPLETED****SECTION PLAT**

C W L NW

1265 Ft. from N. Line

\_\_\_\_\_ Ft. from S. Line

\_\_\_\_\_ Ft. from E. Line

330 Ft. from W. Line

|  |  |  |  |
|--|--|--|--|
|  |  |  |  |
|  |  |  |  |
|  |  |  |  |
|  |  |  |  |

BURRTON POOL

Location \_\_\_\_\_

Rig up \_\_\_\_\_

Drilling and Remarks:

*Miss 3278.**5" @ 3317**2000 acid**Pump 115 P.D.**36 1/2 Bl.***RECORD**

Cased \_\_\_\_\_ in., \_\_\_\_\_ ft.

Sand \_\_\_\_\_

Gas \_\_\_\_\_

Oil \_\_\_\_\_

Total Depth 3361**PRODUCTION**

1st 24 hrs. - Nat. \_\_\_\_\_

1st 24 hrs. after shot \_\_\_\_\_

Gas \_\_\_\_\_ Cu. Ft.

Dry Hole \_\_\_\_\_

Abandoned \_\_\_\_\_

Date

MAR 12 1941 19S. J. LEWIS Scout