

KANSAS

Harvey


Section 18 Township 23 Range 3W

Well No. 2 Hurty

Company H.C. Bennett

Burrton Pool

NORTH

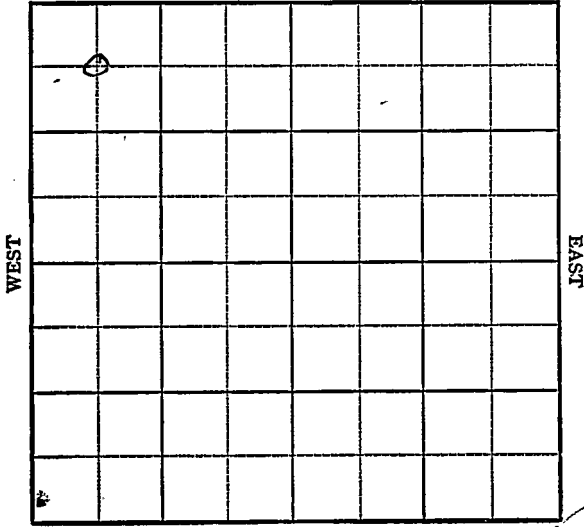

4

SOUTH

Sec. 18 Twp. 23 R. 3-W

Well No. #2 Hurty Farm

H C Bennett Company

Burrton


660 Ft. from N. Line

_____ Ft. from S. Line

_____ Ft. from E. Line

660 Ft. from W. Line

C NW NW

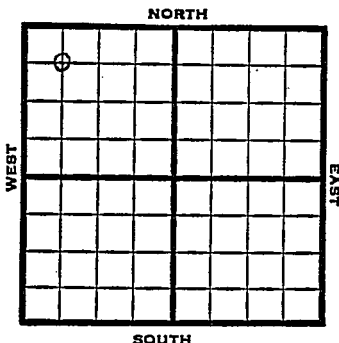

1948 Elev. 1470' REPORT

10/6 8" @ 340'
 10/13 Drlg. 2820'
 10/19 "
 10/26 Miss 3282'
 5" @ 3351'
 Drlg. 3353'
 11/3 TD 3358'
 11/10 "
 11/17 Miss 3282'
 5" @ 3351'
 2000 acid
 Pump 15 oil Pot.
 Gr. 38
 TD 3387'

COMPLETED

Map No. _____ Sec. 18 Twp. 23 R. 3W

Well No. 2 Hurty

H. C. Bennett Company

FIRST REPORT

Contractor

C NW NW

SECTION PLAT

660 Ft. from N. Line

_____ Ft. from S. Line

_____ Ft. from E. Line

660 Ft. from W. Line

Harvey County

Location _____

Rig up _____

Drilling and Remarks:

8" @ 340

RECORD

Cased _____ in., _____ ft.

Sand _____

Gas _____

Oil _____

Total Depth _____

PRODUCTION

1st 24 hrs. Nat. _____

1st 24 hrs. after shot _____

Gas _____ Cu. Ft.

Dry Hole _____

Abandoned _____

Date

OCT 6 1948

19

S. I. LEWIS

Scout

Map No. 39 Sec. 18 Twp. 23 R. 3W

Well No. 2 Hurty

H. C. Bennett Company

COMPLETE

Contractor

C NW NW

E 11470
SECTION PLAT

660 Ft. from N. Line

 Ft. from S. Line

660 Ft. from E. Line

 Ft. from W. Line

0			

Harvey County

Location _____

Rig up _____

Drilling and Remarks:

Min 9282
5" c3351
25-28

RECORD

Cased _____ in., _____ ft.

Sand _____

Gas _____

Oil

Total Depth 3387

PRODUCTION

1st 24 hrs. Nat. _____

1st 24 hrs. after shot _____

Gas _____ Cu. Ft.

Dry Hole _____

Abandoned _____

Date

NOV 17 1948 19

S. J. LEWIS Scout