

KANSAS

Harvey


FORM 51 5M 2-38 TPCO.

Section 18 Township 23 Range 3W

Well No. #1 LeClere

*Central States Oil*

Company ~~E. J. Shaffer~~

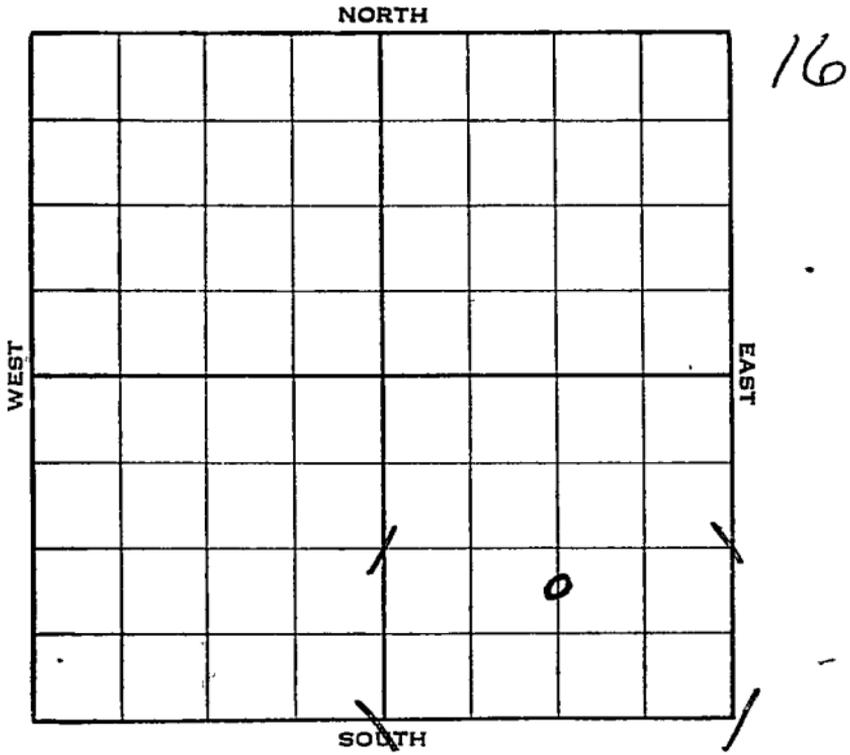

Sec. 18 Twp. 23 R. 3-W

Well No. #1 Leclère Farm

~~E. J. Sheriff~~ Central States Oil Company


\_\_\_\_\_ Ft. from N. Line

990 Ft. from S. Line

1320 Ft. from E. Line

\_\_\_\_\_ Ft. from W. Line

Elev. 1461

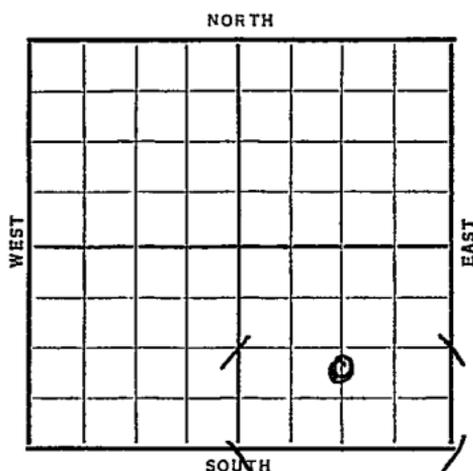

Date	REPORT
1938	
8/3	Cellar.
8/12	"
8/19	B. R. R.
8/26	R. R.
9/2	12" - 265'. Dlg. 620'.
9/9	TD 2800'.
9/16	Chat. 3250'. T. D. 3315'.
9/23	Rng. 7". 7" - 3292'. WOG.
9/30	" " "
10/7	" " "
10/14	" " "
10/21	" " "
10/28	" " "
11/4	" " "
11/12	" " "
11/18	" " "
11/25	T. D. 3363'. 600' oil.
12/2	S.D. tanks.
	4000 acid.

1938

12/7

7" - 3292'.

Chat. 3250'.

T. D. 3363'.

4000 acid.

Flow 242 bbls. 8 hrs.

Potential 725 bbls.

**COMPLETED**



*Harvey* KANSAS

Map No. 39 Sec. 18 Twp. 23 R. 3<sup>W</sup>

Well No. 1 - LeClere

Central States Oil Company

Contractor

**CORRECTION**

\_\_\_\_\_ Ft. from N. Line

990 Ft. from S. Line

1320 Ft. from E. Line

\_\_\_\_\_ Ft. from W. Line

**SECTION PLAT**

			○

**CORRECTION**

Location \_\_\_\_\_

Rig up \_\_\_\_\_

Drilling and Remarks:

*first reported  
as E. J. Shaffer  
changed to  
Central States*

**RECORD**

Cased \_\_\_\_\_ in., \_\_\_\_\_ ft.

Sand \_\_\_\_\_

Gas \_\_\_\_\_

Oil \_\_\_\_\_

Total Depth \_\_\_\_\_

**PRODUCTION**

1st 24 hrs. Nat. \_\_\_\_\_

1st 24 hrs. after shot \_\_\_\_\_

Gas \_\_\_\_\_ Cu. Ft.

Dry Hole \_\_\_\_\_

Abandoned \_\_\_\_\_

Date

SEP 14 1935

19

H. D. Hatfield

Scout

