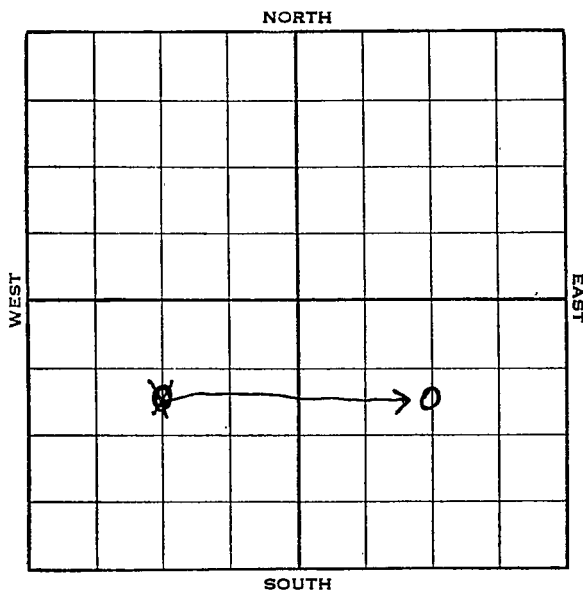


Harvey

Section 18 Township 23 Range 3-WWell No. 1 MartindellCompany Carl Hipple et al

KANSAS


Harvey

Sec. 18 Twp. 23 R. 3-WWell No. #1 Martindell FarmCarl Hipple et al Company990 Ft. from N. Line

Ft. from S. Line

1320 Ft. from E. Line1320 Ft. from W. Line

Elev. 1460

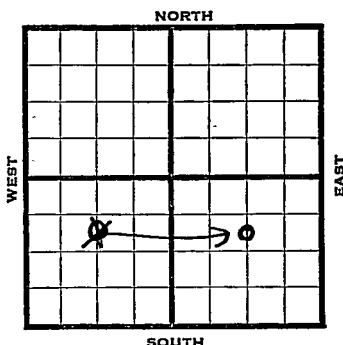

1938	REPORT
5/18	Location
5/27	Mat'l.
6/3	"
6/10	"
6/17	"
6/24	"
7/1	"
7/8	B. R. R.
7/15	12" - 265'. Drlg. 515'.
7/22	Dlg. 2845'.
7/29	Chat 3256'. T. D. 3274'.
	No shows. 6" - 3256'. RUST.
8/5	Chat 3247' (Corrected)
	6" - 3273'. T.D. 3287'.
	5 M gas.
8/12	Dlg. 3343'. 1700' fluid.
8/19	Correction: 3247 equals 3237'.
	Chat 3237'. 6" - 3263'.
	T. D. 3369'. Flowed 463 oil in
	24 hrs. 3000 acid.
	OVER

1938

8/24

6" - 3263'.

Chat. 3237'..

T. D. 3369'.

3000 acid.

Potential 1514 bbls., Flow.

COMPLETED

KANSAS

Harvey

Map No. 37 Sec. 18 Twp. 23 R. 3WWell No. 1 MartindellCarl Hipple etal

Company

Contractor

FIRST REPORT

C S L N $\frac{1}{2}$ SW

SECTION PLAT

990 Ft. from N. Line

_____ Ft. from S. Line

_____ Ft. from E. Line

1320 Ft. from W. LineLocation X

Rig up _____

Drilling and Remarks:

RECORD

Cased _____ in., _____ ft.

Sand _____

Gas _____

Oil _____

Total Depth _____

-PRODUCTION

1st 24 hrs. Nat. _____

1st 24 hrs. after shot _____

Gas _____ Cu. Ft.

Dry Hole _____

Abandoned _____

Date

MAY 18 1938 19

H. D. Hatfield Scout

Harvey KANSASMap No. 39 Sec. 18 Twp. 23 R. 3WWell No. 1-Martindell*Carl Hipple* Company

Contractor

CSL N²SE

CORRECTION


SECTION PLAT

990 Ft. from N. Line

_____ Ft. from S. Line

1320 Ft. from E. Line

_____ Ft. from W. Line

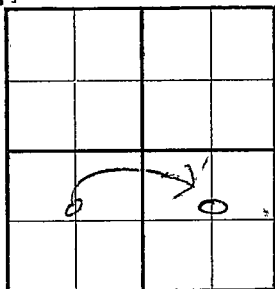

Location _____

Rig up _____

Drilling and Remarks:

first reported
as CSL N²SW
Corrected to
CSL N²SE

RECORD

Cased _____ in., _____ ft.

Sand _____

Gas _____

Oil _____

Total Depth _____

PRODUCTION

1st 24 hrs. Nat. _____

1st 24 hrs. after shot _____

Gas _____ Cu. Ft.

Dry Hole _____

Abandoned _____

Date

MAY 25 1938

19

H. D. Hatfield

Scout

Harvey KANSAS

Map No. 39 Sec. 18 Twp. 23 R. 3WWell No. 1 MartindellCarl Hipple etal CompanyA Contractor

COMPLETED

C S L N $\frac{1}{2}$ SE990 Ft. from N. Line Ft. from S. Line1320 Ft. from E. Line Ft. from W. Line

SECTION PLAT

Location Rig up

Drilling and Remarks:

3000 acidPOT 1514Flow

RECORD

Cased 6 in., 3263 ft.Sand chat 3237Gas Oil Total Depth 3269

PRODUCTION

1st 24 hrs. Nat. 1st 24 hrs. after shot Gas Cu. Ft.Dry Hole Abandoned

Date

AUG 24 193819H. D. Hatfield Scout