

Harvey

KANSAS


Form 51-5M-11-38-Palace

Section 18 Township 23 Range 3-W

Well No. #2 Martindell

Company Jack Davis & Hipple

NORTH Miscellaneous

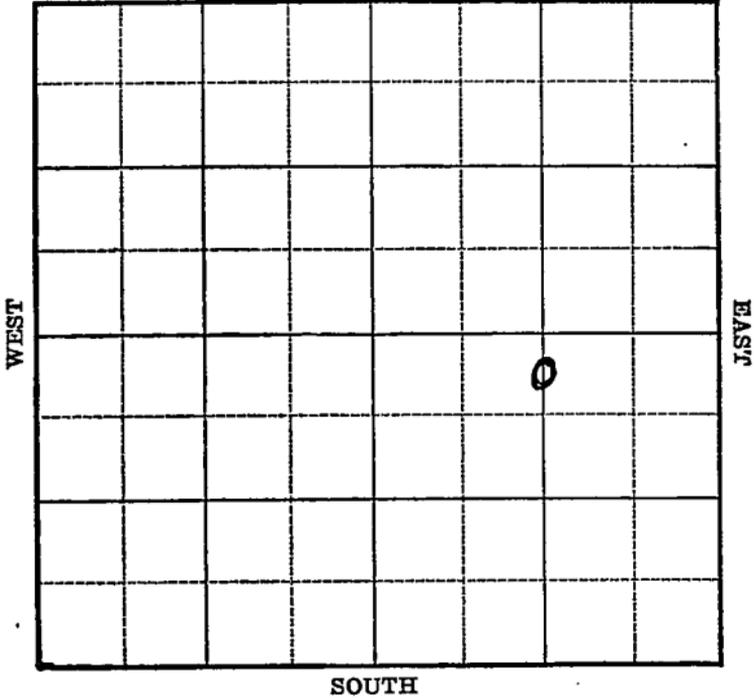



Harvey

KANSAS

Map No. 39 Sec. 18 Twp. 23 R. 3W

Well No. 2 Martindell

Jack Davis & Hipple Company

Contractor

FIRST REPORT  
C N L SE

SECTION PLAT

330 Ft. from N. Line

\_\_\_\_\_ Ft. from S. Line

1320 Ft. from E. Line

\_\_\_\_\_ Ft. from W. Line

		○	

MISCELLANEOUS

Location X

Rig up \_\_\_\_\_

Drilling and Remarks:

RECORD

Cased \_\_\_\_\_ in., \_\_\_\_\_ ft.

Sand \_\_\_\_\_

Gas \_\_\_\_\_

Oil \_\_\_\_\_

Total Depth \_\_\_\_\_

PRODUCTION

1st 24 hrs. Nat. \_\_\_\_\_

1st 24 hrs. after shot \_\_\_\_\_

Gas \_\_\_\_\_ Cu. Ft.

Dry Hole \_\_\_\_\_

Abandoned \_\_\_\_\_

Date

JUN 14 1939

19

S. J. LEWIS

Scout

Map No. 39 Sec. 18 Twp. 23 R. 3WWell No. 2 MartindellJack Davis & Hipple

Company

Contractor

**COMPLETED  
C N L SE**330 Ft. from N. Line       Ft. from S. Line1320 Ft. from E. Line       Ft. from W. Line**MISCELLANEOUS****SECTION PLAT**


Location \_\_\_\_\_

Rig up \_\_\_\_\_

Drilling and Remarks: \_\_\_\_\_

*Chas 3250**7" @ 9271**2000 acid**Pump & flow 1140  
P & J.***RECORD**

Cased \_\_\_\_\_ in., \_\_\_\_\_ ft.

Sand \_\_\_\_\_

Gas \_\_\_\_\_

Oil \_\_\_\_\_

Total Depth 3369**PRODUCTION**

1st 24 hrs. Nat. \_\_\_\_\_

1st 24 hrs. after shot \_\_\_\_\_

Gas \_\_\_\_\_ Cu. Ft.

Dry Hole \_\_\_\_\_

Abandoned \_\_\_\_\_

Date

AUG 2 193919S. J. LEWIS Scout