

# KANSAS

Form 51—5M—7-40—Palace


Harvey

Section 18 Township 23 Range 3-W

Well No. 4 Martindell

Company Hipple Oil

NORTH Burrton Pool

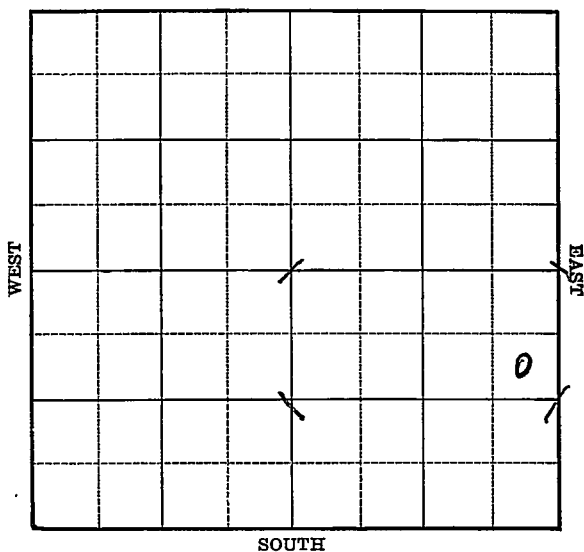


Sec. 18 Twp. 23 R. 3-WWell No. #4 Martindell FarmHipple Oil Company

(Burrtton)

990 Ft. from N. Line         Ft. from S. Line330 Ft. from E. Line         Ft. from W. Line

Elev. 1459

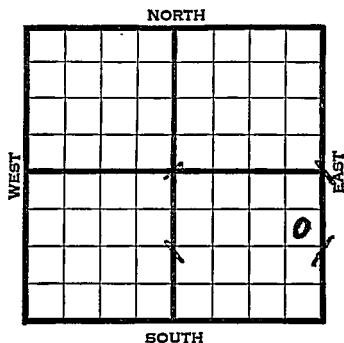

1941

## REPORT

2/19 Rotary.

2/27 10" - 248' Drlg. 1300'

3/6 Drlg. 2890'

3/13 Miss. 3255-60' T.D. 7" - 3260'

RUST.

3/20 Drlg. 3282' 1½ M gas.

3/27 T.D. 3362' 1200' oil.

2000 acid.

4/3 " "

4/10 " "

4/18 " "

4/23 Miss. 3255'

7" - 3260'

T.D. 3362'

2000 acid.

Potential 150 bbls., pump.

36.5 Gravity

COMPLETED

Map No. 39 Sec. 18 Twp. 23 R. 3WWell No. 4 MartindellHipple Oil

Company

FIRST REPORT


Contractor

SE NE SE

## SECTION PLAT

990 Ft. from N. Line       Ft. from S. Line330 Ft. from E. Line       Ft. from W. Line

BURRTON POOL

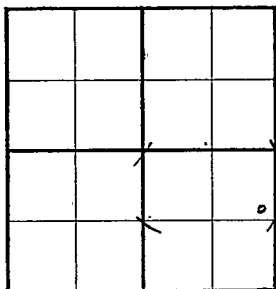Location                                 Rig up                                 Drilling and Remarks:  
Rotary

## RECORD

Cased            in.,            ft.Sand                                 Gas                                 Oil                                 Total Depth                                 

## PRODUCTION

1st 24 hrs.-Nat.                                 1st 24 hrs. after shot                                 Gas                                  Cu. Ft.Dry Hole                                 Abandoned                                 

Date

FEB 19 1941 19

S. J. LEWIS

Scout

Map No. 37 Sec. 18 Twp. 23 R. 3WWell No. 4 MartindaleHipple Oil

Company

**COMPLETED**

Contractor

SE NE SE

## SECTION PLAT

|  |  |  |   |
|--|--|--|---|
|  |  |  |   |
|  |  |  |   |
|  |  |  |   |
|  |  |  | 0 |
|  |  |  |   |

990 Ft. from N. Line

Ft. from S. Line

330 Ft. from E. Line

Ft. from W. Line

BURRTON POOL

Location

Rig up

Drilling and Remarks:

*Well 2255**7" @ 3260**2000 feet**Pump 150 RY**265 Gr*

## RECORD

Cased \_\_\_\_\_ in., \_\_\_\_\_ ft.

Sand \_\_\_\_\_

Gas \_\_\_\_\_

Oil \_\_\_\_\_

Total Depth 2362

## PRODUCTION

1st 24 hrs. Nat. \_\_\_\_\_

1st 24 hrs. after shot \_\_\_\_\_

Gas \_\_\_\_\_ Cu. Ft.

Dry Hole \_\_\_\_\_

Abandoned \_\_\_\_\_

Date

APR 23 1941

19

S. J. LEWIS Scout