


Map No. Harvey Sec. 18 Twp. 23 R. 3WWell No. 1- Sabine "C" FarmOlson-Shell Company

NORTH

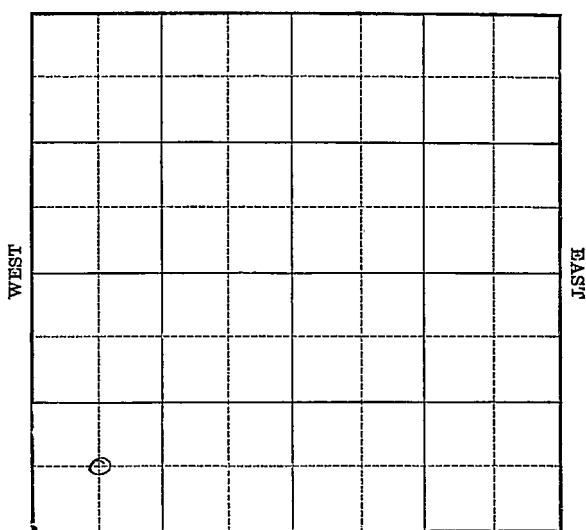

SOUTH

Location \_\_\_\_\_

Drilling Remarks \_\_\_\_\_

\_\_\_\_\_

\_\_\_\_\_

## RECORD

Cased \_\_\_\_\_ in. \_\_\_\_\_ ft.

Sand \_\_\_\_\_

Gas \_\_\_\_\_

Oil \_\_\_\_\_

Total Depth \_\_\_\_\_

Rig Up \_\_\_\_\_

Drilling Remarks \_\_\_\_\_

\_\_\_\_\_

\_\_\_\_\_

## PRODUCTION

1st 24 hrs. Nat. \_\_\_\_\_

1st 24 hrs. after shot \_\_\_\_\_

Gas \_\_\_\_\_ cu. ft.

Dry Hole \_\_\_\_\_

Abandoned \_\_\_\_\_

*Harvey*

Map No. \_\_\_\_\_ Sec. 18 Twp. 23 R. 3W

Well No. 1- Sabin "C" Farm \_\_\_\_\_


Olson-Shell Company

\_\_\_\_\_ Ft. from N. Line

660 Ft. from S. Line

\_\_\_\_\_ Ft. from E. Line

660 Ft. from W. Line

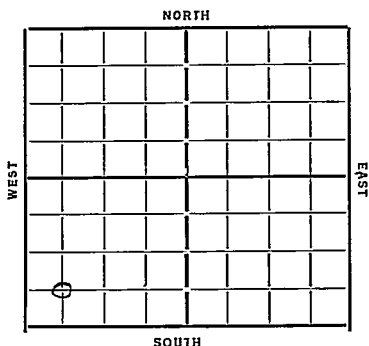

Date 1933

REPORT

5/31 Location

6/18 \_\_\_\_\_

6/18 15" - 20' 3"

6/21 Drly 2000'

6/28 Chat 3280' Running 8" 3294'

7/5 Drly 3298'

7/12 Chat 3284 Corrected show oil 3355'

TD. 338 swap 50 bbls oil 25 water  
will acidize

7/19 Top Chat 3284

T. D. 3380

145 bbls oil

50 " Water

COMPLETED

KANSAS

Harvey  
 Map No. 39 Sec. 18 Twp. 23 R. 3W  
 Well No. 1 Sabin 'C'  
 Olson - Shell Company

Contractor

center SW SW

FIRST REPORT  
SECTION PLATS

|   |  |  |  |
|---|--|--|--|
|   |  |  |  |
|   |  |  |  |
|   |  |  |  |
|   |  |  |  |
| 0 |  |  |  |

Ft. from N. Line

660 Ft. from S. Line

Ft. from E. Line

660 Ft. from W. Line

Location ✓

Rig up

Drilling and Remarks:

## RECORD

Cased.....in., .....ft.

Sand.....

Gas.....

Oil.....

Total Depth.....

## PRODUCTION

1st 24 hrs. Nat.....

1st 24 hrs. after shot.....

Gas.....Cu. Ft.

Dry Hole.....

Abandoned.....

Date

5/31/33 192

O. Mannscheck Scout

Harvey  
 Map No. 320 Sec. 18 Twp. 23 R. 3W

Well No. 1 Sabin - C

Olson - Shell Company

Corrich - Frank Contractor

Twp 22 to 23

## SECTION PLAT


660 Ft. from N. Line

660 Ft. from S. Line

660 Ft. from E. Line

660 Ft. from W. Line

COMPLETED

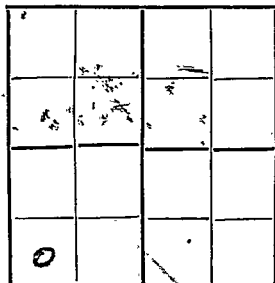

Location.....

Rig up.....

Drilling and Remarks:

Chat 3284

145 oil +  
50 water

## RECORD

Cased.....in., .....ft.

Sand.....

Gas.....

Oil.....

Total Depth 3380

## PRODUCTION

1st 24 hrs. Nat.....

1st 24 hrs. after shot.....

Gas.....Cu. Ft.

Dry Hole.....

Abandoned.....

Date

7/19/33 192 Oval Mansel Scout