

Section 18 Township 23 Range 3-W


Well No. #2 Short

Company H G Bennett
Burton Pool

NORTH

WEST

EAST

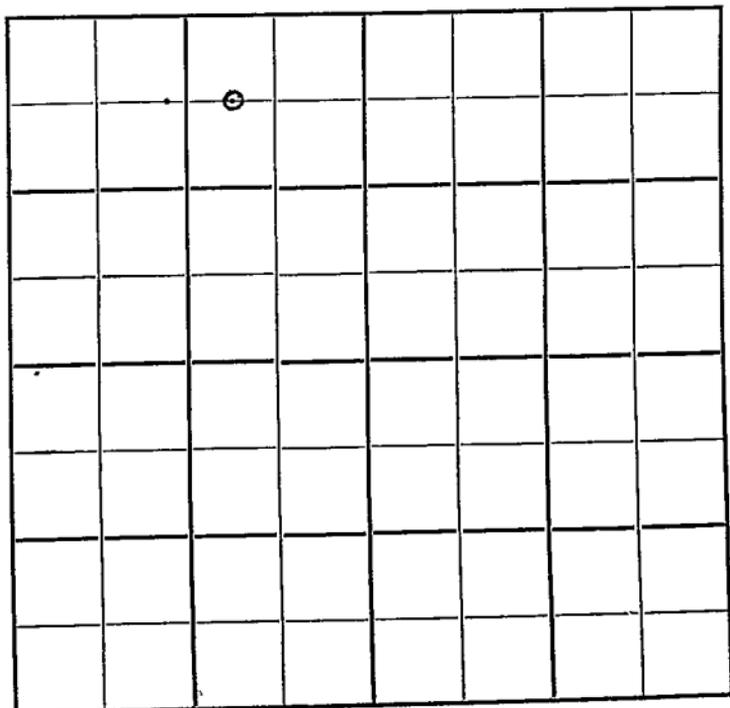

SOUTH

3

Sec. 18 Twp. 23 R. 3W

Well No. #2 Short Farm

H. C. Bennett

Burrton Pool (B & R Drlg. Contr. Company)


660' Ft. from N. Line

_____ Ft. from S. Line

990' Ft. from E. Line

_____ Ft. from W. Line

C W L NE NW

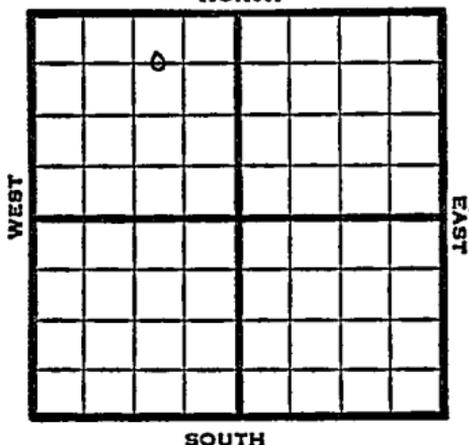

1949 ^uElev 1470' REPORT

11/30 8" @ 250'
 Drlg. 2320'
 12/7 Miss 3278'
 TD 3331
 5" @ 3324'

12/14 TD 3338'
 12/21 TD 3373'
 Miss 3278'
 5" @ 3324'
 1500 acid
 Pump 45 Oil Pot
 38° Gr.
 Comp

COMPLETED

Kansas

Map No. _____ Sec. 18 Twp. 23 R. 3W

Well No. 2 Short

H. C. Bennett Company

B & R Drlg. Contractor

C W L NE NW

FIRST REPORT
SECTION PLAT

660 Ft. from N. Line

_____ Ft. from S. Line

990 Ft. from E. Line

_____ Ft. from W. Line

	o		

Harvey County

Location _____

Rig up _____

Drilling and Remarks:

8" @ 250

drlg. 2320

RECORD

Cased _____ in., _____ ft.

Sand _____

Gas _____

Oil _____

Total Depth _____

PRODUCTION

1st 24 hrs. Nat. _____

1st 24 hrs. after shot _____

Gas _____ Cu. Ft.

Dry Hole _____

Abandoned _____

Date

NOV 30 1949 19

S. J. LEWIS Scout

Map No. _____ Sec. 18 Twp. 23 R. 3W

Well No. 2 Short

H. C. Bennett Company

COMPLETE

Contractor

C W L NE NW

E11470
SECTION PLAT

660 Ft. from N. Line

_____ Ft. from S. Line

990 Ft. from E. Line

_____ Ft. from W. Line

Harvey County

RECORD

Location _____

Cased _____ in., _____ ft.

Rig up _____

Sand _____

Drilling and Remarks:

Gas _____

Misc 3278

Oil _____

5" C 3324

Total Depth 3323

1500 cu ft

PRODUCTION

Prod 45 oil @ 28°

1st 24 hrs. Nat. _____

1st 24 hrs. after shot _____

Gas _____ Cu. Ft.

Dry Hole _____

Abandoned _____

28° Se

Date

DEC 21 1949

19

S. J. LEWIS

Scout