

KANSAS


Form 51-5M-7-39-Palace

Harvey

Section 18 Township 23 Range 3-W

Well No. #3 Martindell

Company Carl Hipple Oil

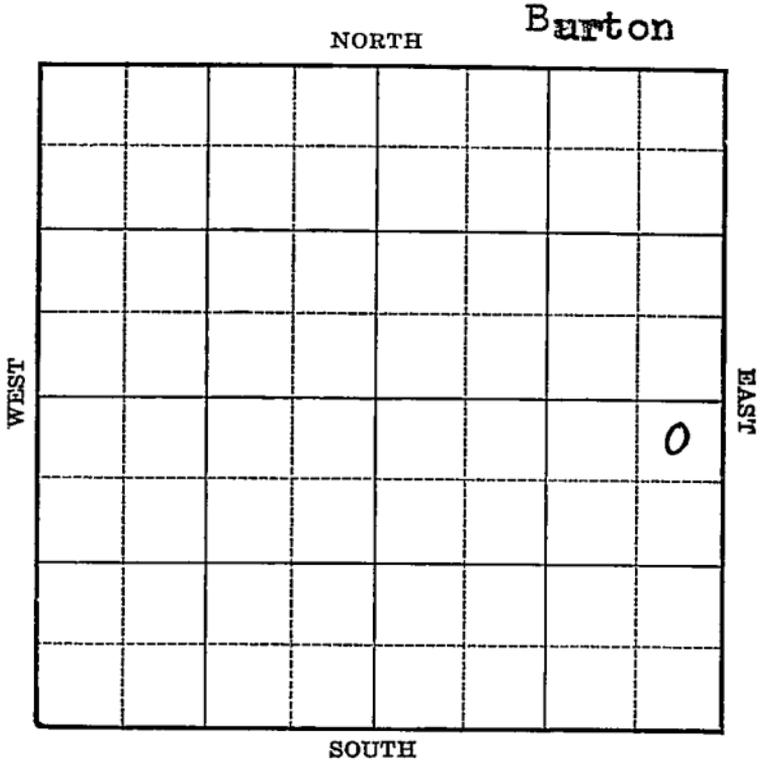

Sec. 18 Twp. 23 R. 3-W

Well No. #3 Martindell Farm

Carl Hipple Oil Company

(Burton)


330 Ft. from N. Line

_____ Ft. from S. Line

330 Ft. from E. Line

_____ Ft. from W. Line

Elev. 1461

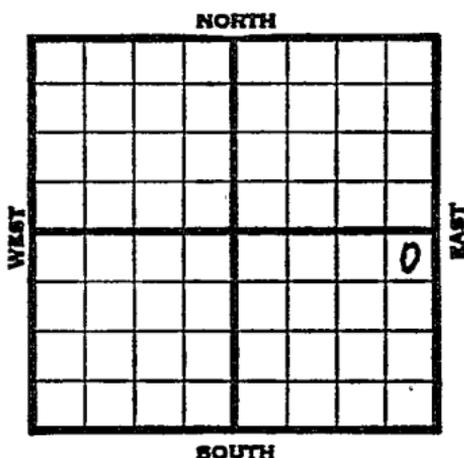

1939	REPORT
9/27	Location
10/5	Cellar.
10/12	"
10/19	"
10/26	"
11/2	10" - 285'
	Drlg. 300'
11/9	Drlg. 2300'
11/16	Lans. 2918' Drlg. 2996'
11/23	Chat 3250' 7" - 3308' RUST.
11/29	Drlg. 3357' 2200' oil.
12/7	T.D. 3357' 3000 acid. No test.
12/13	Chat. 3250'
	7" - 3308'
	T.D. 3357'
	3000 acid.
	Potential 78 bbls., flow.
	COMPLETED

Harvey

KANSAS

Map No. 39 Sec. 18 Twp. 23 R. 3WWell No. 3 Martindell

Carl Hipple Oil

Company

Contractor

FIRST REPORT
NE SE330 Ft. from N. Line

_____ Ft. from S. Line

330 Ft. from E. Line

_____ Ft. from W. Line

Burton Pool

SECTION PLAT

			o

Location X

Rig up _____

Drilling and Remarks:

RECORD

Cased _____ in., _____ ft.

Sand _____

Gas _____

Oil _____

Total Depth _____

PRODUCTION

1st 24 hrs. Nat. _____

1st 24 hrs. after shot _____

Gas _____ Cu. Ft.

Dry Hole _____

Abandoned _____

Date

SEP 6 1939

19

S. J. LEWIS

Scout

Harvey

KANSAS

Map No. 39 Sec. 18 Twp. 23 R. 3WWell No. 3 MartindellCarl Hipple Oil

Company

Contractor

COMPLETED

NE SE

SECTION PLAT

330

Ft. from N. Line

Ft. from S. Line

330

Ft. from E. Line

Ft. from W. Line

			o

BURRTON POOL

Location _____

Rig up _____

Drilling and Remarks:

*Chas 3250**7" C 3308**3000 gal**Flow 78 1/2 lb. P.S.*

RECORD

Cased _____ in., _____ ft.

Sand _____

Gas _____

Oil _____

Total Depth 3352

PRODUCTION

1st 24 hrs. Nat. _____

1st 24 hrs. after shot _____

Gas _____ Cu. Ft.

Dry Hole _____

Abandoned _____

Date

DEC 13 1939

19

S. J. LEWIS

Scout