


Section 18 Township 23 Range 3W

Well No. #2 Wiley

Company S. Lebow

Burrton

NORTH

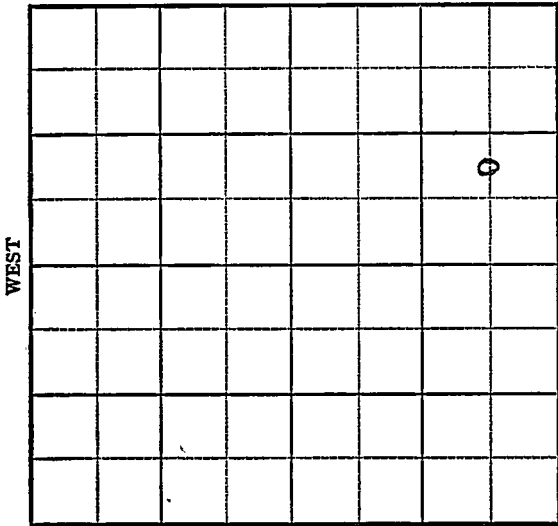

SOUTH

8

Sec. 18 Twp. 23 R. 3-W ✓

Well No. #2 Wiley Farm

S. Letow Company


Burrton

 Ft. from N. Line

990 Ft. from S. Line

660 Ft. from E. Line

 Ft. from W. Line

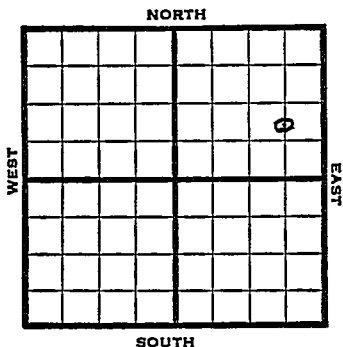

C N L SE NE.

1948		REPORT
10/13	Eli 1466'	8" @ 263' Drlg 650
10/19	Mississippi 3274'	TD 3335' 5" @ 3300'
10/27	TD 3358'	Miss 3274' 5" @ 3310' 1000 acid Pump 75 oil Pot 38° Gr. Comp

COMPLETED

Map No. _____ Sec. 18 Twp. 23 R. 3W

Well No. 2 Wiley

S. Lebow Company

FIRST REPORT

Contractor

C N L S E N E

SECTION PLAT

_____ Ft. from N. Line

990 Ft. from S. Line

660 Ft. from E. Line

_____ Ft. from W. Line

			o

Harvey County

Location _____

Rig up _____

Drilling and Remarks:

8" @ 263

drlg. 650

RECORD

Cased _____ in., _____ ft.

Sand _____

Gas _____

Oil _____

Total Depth _____

PRODUCTION

1st 24 hrs. Nat. _____

1st 24 hrs. after shot _____

Gas _____ Cu. Ft.

Dry Hole _____

Abandoned _____

Date

OCT 13 1948

19

S. J. LEWIS

Scout

