


Section 18 Township 23 Range 11 W

Well No. # 1 Hornbaker

Company Barnett Oil

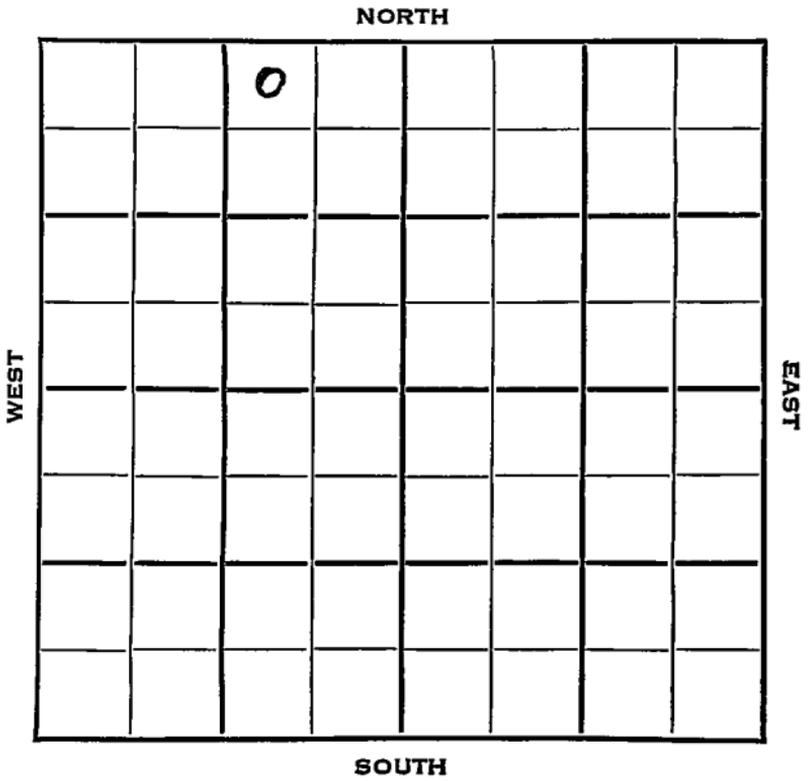

Stafford

KANSAS

SEC.	TWP.	R.
18	23	11 W

WELL NO.

1 Hornbaker

FARM

COMPANY

Barnett Oil

CONTRACTOR

Barnett

Brock Pool

330 Ft. from N. Line


Ft. from S. Line

990 Ft. from E. Line

Ft. from W. Line

NW NE NW

Phillips Farmout

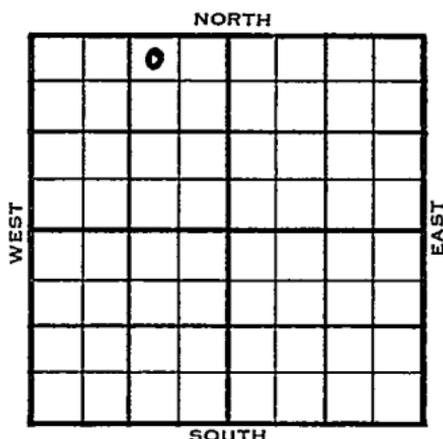

	ELEVATION	REPORT
1953	1826'	

10/14 Spud 10-10-53
8" @ 245
Drlg. 1515'

10/21 Heeb 3136, Br. L. 3284, Lans 3313,
Drlg 3515'

10/28 Spud 10-10-53 D & A TD 3724'
8" @ 245 Heeb 3136 Br. lime 3284'
Lans. 3313' Viola 3500' Arb. 3705'
DST 3706-09 open 1 hr rec 225' sul.
wtr. 1060# TD 3724' D & A

ABANDONED


County **Stafford** State **Kansas**

Sec. **18** (Blk. Twp.) **23** (Sur. Rge.) **11W** Map No.

Operator **Barnett Oil**

Well No. **1** Farm **Hornbaker**

Elev. Location **NW NE NW**

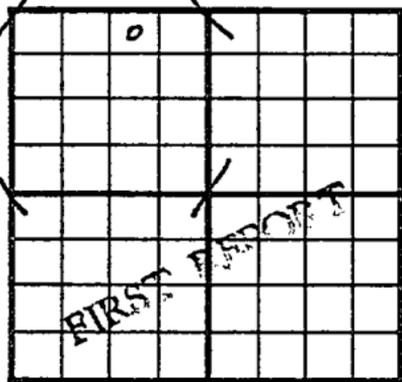

330 Ft. From **N** Line **NW**

990 Ft. From **E** Line **Quarter**

1st. Report **OCT 14 1953**

Completion

Remarks **Phillips farmout**

Barnett - Contr.

Spudding Date **10-10-53**

Drlg. Data **Brook Pool**

8" @ 245 drlg. 1515


County Stafford State Kansas

Sec. 18 (Blk. 23) (Sur. 11W) (Twp. Rge.) Map No.

Operator Barnett Oil

Well No. 1 Farm Hornbaker

Elev. 1826 Location NW NE NW

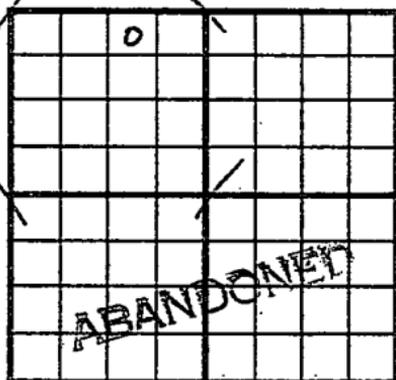

330 Ft. From N Line NW

990 Ft. From E Line Quarter

Ist. Report

Completion OCT 28 1953

Remarks Brock Pool

Barnett - Contr.

Spudding Date 10-10-53

Drilg. Data D & A TD 3724

8" @ 245 Heeb. 3136 Br. lime 3284

Lans. 3313 Viola 3590 Arb. 3705

DST 3706-09 open 1 hr. Rec. 225' sul.

wtr. 1060# TD 3724

D & A