


Section 18 Township 23 Range 13 W

Well No. #2 Gray

Company Sterling Drlg.

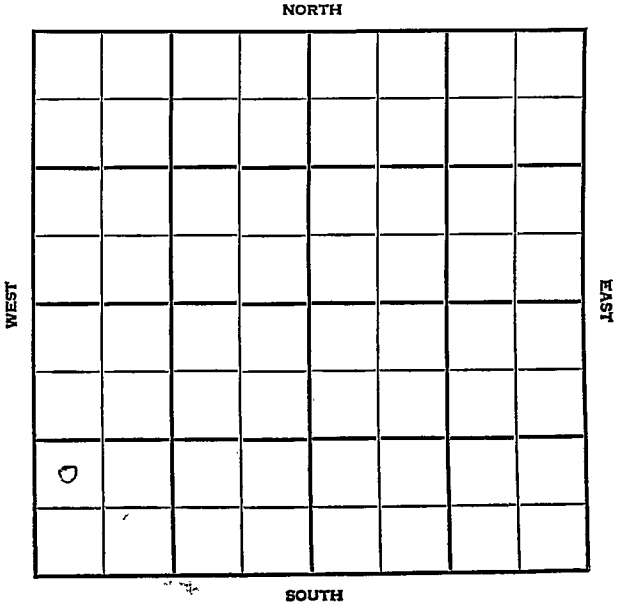

SEC. 18	TWP. 23	R. 13W
------------	------------	-----------

WELL NO.

#2 Gray

FARM

COMPANY

Sterling Drlg.

CONTRACTOR

Co. Tools

Brenn

_____ Ft. from N. Line

_____ Ft. from S. Line

_____ Ft. from E. Line

_____ Ft. from W. Line

NW SW SW

NORTH

WEST

EAST

SOUTH

1956

ELEVATION

1908'

REPORT

3-14

Comm. 3-10-56
8" @ 368/125
Drlg. 1950

5-9

5 $\frac{1}{2}$ " @ 3989/150
CO. to 3954, 24/ 3661-67, PB 3650
32/ 3618-26, 1500 A, FU 1400' oil
P/ 41.76 bo, 8 hrs.,
P/ 125' bopd, 2% wtr.;
H. 3345', Dg. sh. 3391, BL 3487', ~~fx~~
L. 3500', Marm 3745', C.Cherty 3806',
V. 3845', S.Sh. 3901, A. 3960',
TD 3990',

COMPLETED

County Stafford Elev. _____
 Sec. 18 Twp. 23 Rge. 13W
 Company Starling Drlg.
 FarmName Gray No. 2

TOPS	DEPTH	LOG	DATUM
Anh.			
Tp.			
H.			
Tr.			
Dg.			
Bl.			
L.			
K.C.			
B.K.C.			
Ce.			
C.			
M.			
M.			
K.			
Mz.			
Me.			
V.			
S.			
S.			
A.			
R.			
PE.			
G.			
T.D.			

Loc. in Sec. NW SW SW

Geol. _____

Contr. _____

Co. tools _____

Pool _____

Brent _____

MAR 14 1956

Date Comm. 3-10-56
8" @ 368/125 drlg. 1950

13

Co.

Lse.

No.

Sec.

T.

R.

County Stafford Elev. 1908
 Sec. 18 Twp. 23 Rge. 13W
 Company Sterling Drlg. & Childs Bros.
 Farm Name Gray No. 2

TOPS	DEPTH	LOG	DATUM	Loc. in Sec.
Anh.				NW SW SW
TP.				
H.	<u>3345</u>			
Tr.				
Dg. <u>sh</u>	<u>3391</u>			
Bl.	<u>3487</u>		<u>1579</u>	
L.	<u>3506</u>		<u>1592</u>	
K.C. <u>Marm</u>	<u>3745</u>		<u>1837</u>	Geol.
B.K.C.				Contr.
Ce.				Co. tools
C. <u>Cherty</u>	<u>3806</u>		<u>1898</u>	
M.				Pool
M.				<u>Brenn</u>
Kz.				
Me.				
V.	<u>3845</u>		<u>1937</u>	
S. <u>sh</u>	<u>3901</u>		<u>1993</u>	
S.				
A.	<u>3960</u>		<u>2052</u>	COMPLETE
R.				
PE.				
G.				
TD.	<u>3990</u>			

Date Comm. 3-10-56 MAY 9 1956

8" @ 368/125 5 $\frac{1}{2}$ " @ 3989/150

CO to 3954 24/ 3661-67 PB 3650

32/ 3618-26 1500 A FU 1400' oil

P/ 41,76 bo 8 hr. P/ 125 bopd 2% wtr.

Comp.