

Pawnee


KANSAS

SECTION 18 TOWNSHIP 23 RANGE 17 W

WELL NO. #6 Spence

COMPANY Westpan-Hydrocarbon

NORTH

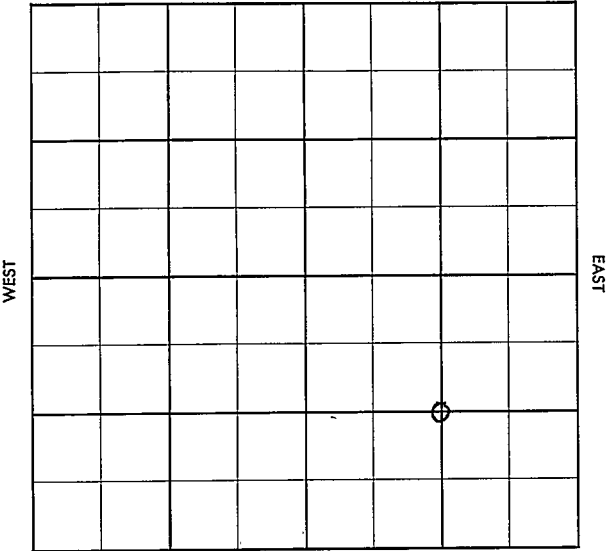

SOUTH

Pawnee

KANSAS

SEC.	TWP.	R.
18	23	17W

WELL NO.

#6 Spence

FARM

COMPANY

Westpan-Hydrocarbon

CONTRACTOR

Hilton

Garfield


_____ Ft. from N. Line

_____ Ft. from S. Line

_____ Ft. from E. Line

_____ Ft. from W. Line

C SE/4

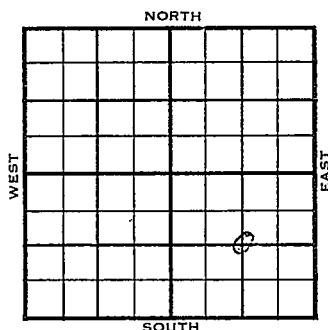

1955

ELEVATION

2112

REPORT

12-7

Comm. 12-5-55

1956

1-25

8 5/8" @ 228/200

DST 4250-68 op 1 1/2 hr. rec. 485' oil,
1200/30"DST 4275-4300 op 1 1/2 hr. rec. 650'
hocm, 1200' sw, 1290/30"

5 1/2" @ 4373

CO 48/ 4276-84

S/ 11.12 bfph 38% wtr. 8 hrs.

Comp. 164 bopd, 20% wtr.

H. 3692

BL. 3798

L. 3807

C. Shly 4236

Cong sd. 4240

Cong chert 4250

Mz. 4348

V. 4369

TD 4375

COMPLETED

२

County Paynee Elev. 2112
 Sec. 18 Twp. 23 Rge. 17W
 Company Westpan-Hydrocarbon
 Farm Name Spence No. 6

TOPS	DEPTH	LOG	DATUM
Anh.			
Tr.			
H.	<u>3692</u>		
Tr.			
Dg.			
BL.	<u>3798</u>		
L.	<u>3807</u>		
K.C.			<u>No 95</u>
B.K.C.			
Ce.			
C.	<u>shlu</u> <u>4236</u>		<u>2124</u>
M.	<u>Comp. Ad.</u> <u>4240</u>		<u>2128</u>
M.	<u>Comp. Ad.</u> <u>4250</u>		<u>2138</u>
K.			
Mz.	<u>4348</u>		<u>2236</u>
Mq.			
V.	<u>4369</u>		<u>2257</u>
S.			
S.			
A.			
R.			
Pe.			
G.			
T.D.	<u>4325</u>		

Loc. in Sec. C SE/4

Geol.

Contr.

Hilton

Pool

Garfield

COMPLETE

Date Comm. 12-5-55 JAN 25 19568 5/8" @ 228/200 DST 4250-68open 1 1/2 hr. rec. 485' oil 1200/30"DST 4275-4300 open 1 1/2 hr. rec. 650'hocm 1200' sw 1290/30" 5 1/2" @ 4373CO 48/ 4276-84 S/ 11.12 bfph38% wtr. 8 hr. Comp. 164 bopd 20% wtr.