


Section 18 Township 23 Range 17W

Well No. #2 Spence

Company Hilton Drlg.

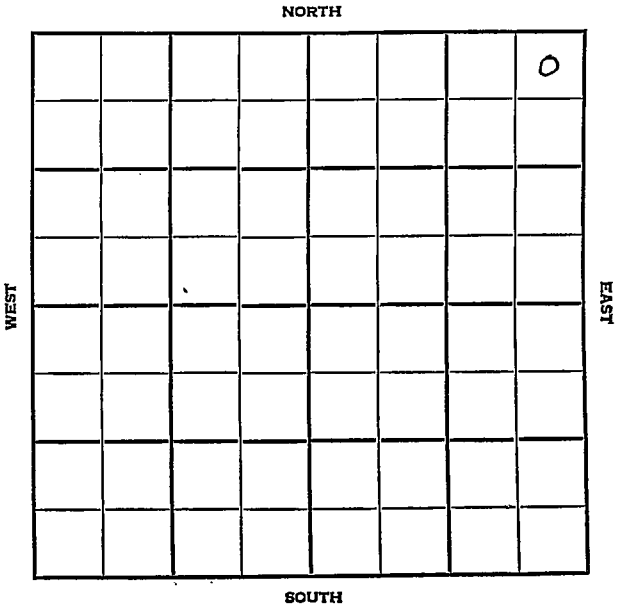

SEC.	TWP.	R.
18	23	17 W

WELL NO. #2 Spence FARM

COMPANY Hilton Drlg.

CONTRACTOR Co. tools

Garfield Pool


330 Ft. from N. Line

Ft. from S. Line

330 Ft. from E. Line

Ft. from W. Line

NE NE NE

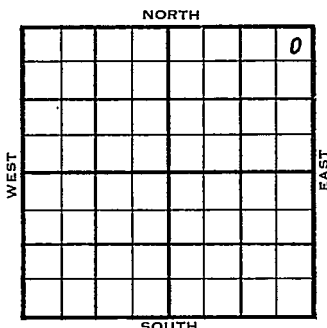

	ELEVATION	REPORT
1954	2093'	

12/1 Spud 11-26-54  
8" @ 235  
Drlg. 1925'

1955  
1/12 Spud 11-26-54 - Oil Well  
TD 4339'  
8" @ 235'  
Heeb. 3674', Br lime 3780', Lans. 3788', Cong. 4236'  
DST 4226-52', opn 1 hr., gas in 19", rec. 270' free oil, 90' muddy oil, 150' ocm, 1010#  
Miss 4256'  
DST 4256-78', opn 1½ hrs., gas in 5", rec. 4250' oil, 1215#  
Misener 4286'  
TD 4339'  
5" @ 4338'  
Viola 4323'  
CO to 4320'  
32/4260-68,  
FU 2000' oil 2 hrs., 500,000 cfg, frac S/18 to 19 boph 4 hrs.  
F/20 boph, F/19 boph 1% wtr.  
Comp. 325 bopd 2% wtr.



